

SUNF, MISSISSIPPI BOARD OF WATER COMMISSIONERS

L 24

10-29-62

WATER WELL DRILLERS LOG

CODED

Sunflower

Date: 10/29, 1962, Driller: Bailey Drilling Co. County: Washington

(Name)

(1) Owner of Land: J H Rodd
 (Name)
Blaine, Miss.
 (Address)

(2) Location: 1/4, 1/4, Sec. 23 T20 R3,
5 miles NE of Sunflower
 (distance) (direction) (Nearest Town)

(3) Topography: Flat
 (Hilly) (Flat) (Level) ^

(4) Purpose of Well: Domestic
 (Domestic Irrigation
 Municipal, Industrial, Other)

Description & Color of Materials Sand, Clay, Red Clay, Shell, etc.	Thick- ness Feet	Depth Feet
Clay		14
Sand		45
Gravel		105
Mud		457
Sand + Mud		471
Sand		564
Mud		610
Sand		628
Mud		685
Rocks		691
Mud		721
Sand + Mud		766
Mud		770
Green Sand + Mud		780
Rocks		855
Green Sand + Mud		870
Rocks		890
Green Sand + Mud		930
Sand		956
Mud		963
Sand		978
Mud		984
Sand + Mud		1032
Mud		1110
Sand + Mud		1155
Sand		1186
Hard Sand		1196
Mud		1250
Sand		1289

Information upon completion of well:

(1) Diameter 4 X 3 inches.

(2) Total Depth 1289 feet.

(3) Water Level 25 feet above top of ground.

(4) Cased to all way Size 4 X 3


(5) Screen: Size 3, Length 30 ft

(6) Were any formations sealed against pollution?
yes, no.

If YES depth of formation

Why

Drillers Remarks:

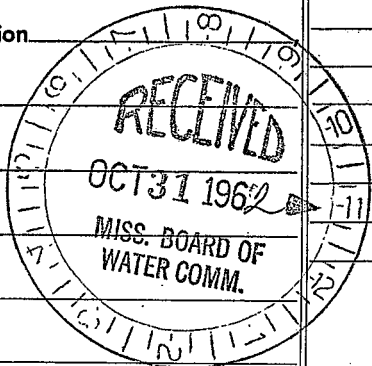

(Use Back Side)

Well No.










