SUNFLOWER
N 2001
8-22-78

MISSISSIPPI
BOARD OF WATER COMMISSIONERS
416 North State Street
Jackson, Mississippi 39201

WATER WELL DRILLERS LOG

BUTANE GAS COMPANY OF GREENWOOD
(firm name)

8/22/78 19
date well completed

Sunflower
county well located

LANDOWNER: David Varnado

Indianola
(mailing address)

WELL LOCATION:
sec. 15 T 19 N/S R 4 E/W

2½ miles N.E. of Indianola
(distance) (direction) (nearest town)

WELL PURPOSE: Home
(home, irrigation, municipal, industrial)

WELL COMPLETION DATA:

(1) diameter (inches) 4X2

(2) total depth (feet) 815

(3) static water level (feet) 18 below/above top of ground.

(4) casing Steel (material), 799 (depth),
4X2 (size) if telescope see back.

(5) screen 16 (length), 799 (depth to top)
2" (size), Stainless (material)

(6) pump 1 (HP) 20 (yield gpm)
Elec. (type power)

(7) electric log No (yes or no)

(organization running log)

(8) how well bottom plugged Back Pressure Valve

DRILLERS REMARKS:

description of formations encountered	from	to
Clay	0	18
Sand	18	70
Sand & Pea Gravel	70	93
Gravel	93	130
Clay	130	155
Shale & Sand	155	180
Sand	180	330
Shale & Sand	330	390
Brown Shale	390	420
Sandy Shale	420	490
Gummy Shale	490	515
Shale & Rock	515	600
Gummy Shale	600	690
Fine Sand & Shale	690	730
Fine Sand	730	745
Sand & Shale	745	760
Hard Packed Sand	760	817

RECEIVED
AUG 25 1978
MISS. BD. OF WATER COMM

If well telescopes please sketch and show depths.

GROUND LEVEL

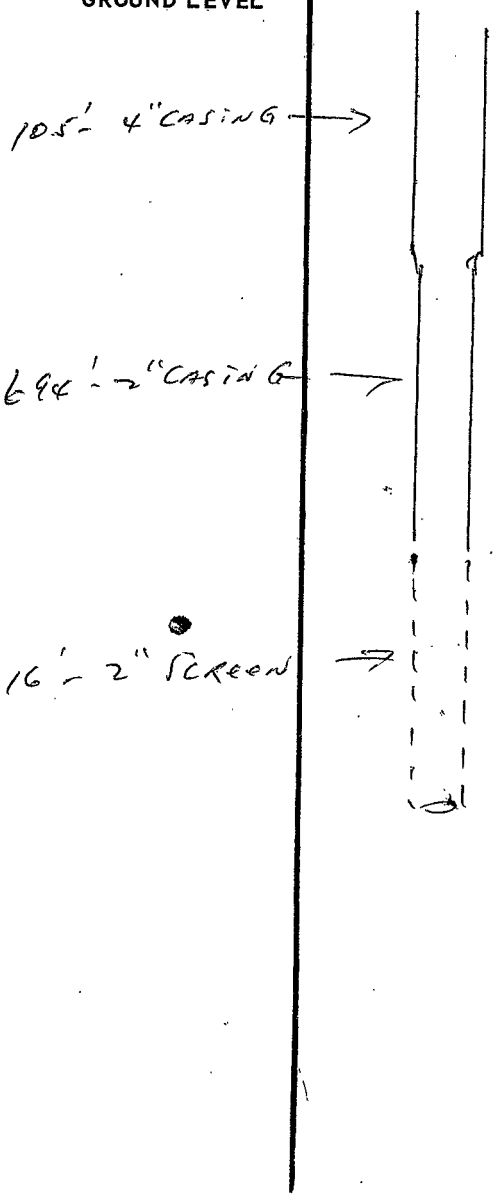

If more than one screen, show locations of each on sketch.

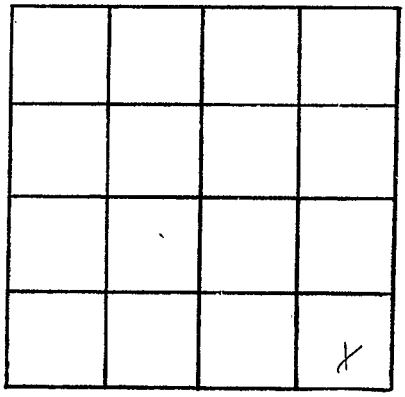

SECTION 15

Please indicate well location X.

ADDITIONAL INFORMATION