MISSISSIPPI DEPARTMENT OF ENVIRONMENTAL QUALITY
Office of Land and Water Resources
P. O. Box 10631
Jackson, MS 39289-0631
WATER WELL DRILLERS LOG

COUNTY WELL LOCATED	Sunflower
WELL NUMBER	N 2035
CODED	
PERMIT NUMBER	
NAME OF DRILLING FIRM	Irrigation Equipment Inc
	Indianola, MS 38751
DATE WELL COMPLETED	8-14-98

NAME & MAILING ADDRESS OF LANDOWNER
L & L Farms
Box 1519
Indianola, MS 38751

WELL LOCATION: SEC	TOWNSHIP	RANGE
7	19N (N / S)	4W (E / W)

DISTANCE	DIRECTION	NEAREST TOWN
4 Miles	North	of Indianola

OTHER LANDMARK

WELL PURPOSE: Home, Irrigation, Municipal, Industrial, Fish Pond, etc.
Irrigation Pivot

PUMP DATA

PUMP TYPE (Circle One): Submersible, Turbine, Jet, Flowing Well, Other (Describe) _____

POWER TYPE (Circle One): Electric, Tractor, Diesel, Gasoline, Butane, Other (Describe) _____ H/P 60

Pump Capacity (GPM)	No. of Stages	Setting Depth
	3	60 FT.

PUMP TEST
Well yielded _____ GPM with a drawdown of _____ ft. after _____ hours of pumping

WELL DATA

Well Depth	Casing Diameter (In.)	Casing Length (Ft.)
116	16	76

Type of Casing	Hole Depth	Depth to Static Water Level
PVC	116	32 ft.

TYPE OF COMPLETION: (Circle One or More): Gravel Packed, Underreamed, Telescoped, Natural Development, Open Hole, Other (Describe) _____

WELL GROUTED TO A DEPTH OF _____ FEET
Type Grout (circle one): Cement, Bentonite, or Mix

LOG DATA

TYPE OF LOG RUN (Circle One): No Log Run, Electric, Gamma Ray, Density, Sonic, Neutron, Other (Describe) _____

Name of Organization Running Log

GEOLOGIC DATA (Office Use Only)

Surface Elev.	Geologic Unit	Unit Thickness	Depth to Top
Subs. SWL	Date	Analysis	Aquifer Test

Driller's Remarks

SCREEN DATA

Diameter - Inches	Length - Feet	Slot Size - Inches
16	40	.050

Screen Type	Depth to Bottom - Feet
PVC	116

Top of Lap Pipe or Reduction in Casing
FEET — IF TELESCOPED OR MORE THAN ONE SCREEN: USE BACK PAGE

DESCRIPTION OF FORMATIONS ENCOUNTERED	FROM	TO
Clay	0	18
Fine Sand	18	55
Fine Sand & Gravel	55	65
Med. Sand & Gravel	65	116

FORMATIONS (Continued)	FROM	TO

RECEIVED
OCT 16 1998
Dept of Environmental Quality
Office of Land & Water Resources

IF MORE SPACE IS NEEDED, USE BACK

If well telescopes please
sketch and show depths.

GROUND LEVEL

 

If more than one screen,
show location of each on sketch.

			X

SECTION 7

Please indicate well location X.

ADDITIONAL INFORMATION