Sunflower
Ø14
5-1-72

MISSISSIPPI
BOARD OF WATER COMMISSIONERS
416 North State Street
Jackson, Mississippi 39201

CODED

WATER WELL DRILLERS LOG

MAY 1 1972 — date well completed
OWENS PLUG. — firm name
SUNFLOWER — county well located

LANDOWNER: O.L. DEAN
P.O. BOX 621
MOORHEAD MS.
(mailing address)

WELL LOCATION:
sec 31 T 19 (N) R 3 (W)
3 (distance) miles W (direction) of MOORHEAD (nearest town)

WELL PURPOSE: HOME
(home, irrigation, municipal, industrial)

WELL COMPLETION DATA:
(1) diameter (inches) 2"
(2) total depth (feet) 420'
(3) static water level (feet) 23 below above top of ground.
(4) casing GALV. (material), 400' (depth),
(size) if telescope see back.
(5) screen 20' (length), 420 (depth to top)
2" (size), S.S (material)
(6) pump 1 (HP) 12 GPM (yield gpm)
ELEC. (type power)
(7) electric log NO (yes or no)
(organization running log)
(8) how well bottom plugged S/B

DRILLERS REMARKS: OWENS

description of formations encountered	from	to
top soil	0	27
Sand + gravel	27	146
Clay	146	247
Sand TESS	247	420

CODED

MAY 11 1972
MISS. BD. OF WATER COMM.

If well telescopes please sketch and show depths.

GROUND LEVEL

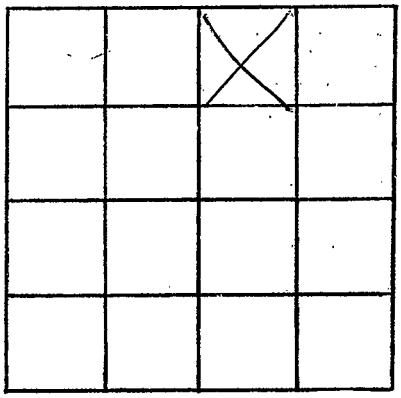

SECTION _____

Please indicate well location X.

ADDITIONAL INFORMATION

If more than one screen, show locations of each on sketch.