

SUNFLOWER MISSISSIPPI BOARD OF WATER COMMISSIONERS

OR 27

11-11-63

WATER WELL DRILLERS LOG

CODED

Date: 11/11, 1963, Driller: Bailey Drilling Co, County: Washington

(1) Owner of Land: Mrs. Merle Anderson, Inverness, Miss.

(2) Location: 1/4, 1/4, Sec. 32 T18N R3W, 4 miles E of Inverness

(3) Topography: Flat


(4) Purpose of Well: Domestic

Table with 3 columns: Description & Color of Materials, Thickness Feet, Depth Feet. Rows include Clay, Gravel, Mud + Sand, Mud, Sand, Rock, etc.

Information upon completion of well:

- (1) Diameter: 3x2 inches. (2) Total Depth: 1354 feet. (3) Water Level: 40 feet above top of ground. (4) Cased to: all way, Size 3x2. (5) Screen: Size 2, Length 20. (6) Were any formations sealed against pollution? yes, X no.

CODED

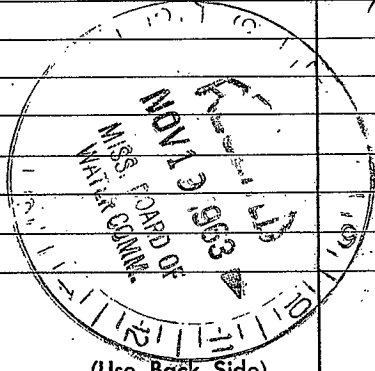

(Use Back Side)

Well No.










