SUNFLOWER
R 135

MISSISSIPPI DEPARTMENT OF NATURAL RESOURCES

Bureau of Land and Water Resources
Southport Mall
P.O. Box 10631
Jackson, Mississippi 39209

CODED

WATER WELL DRILLERS LOG

Jun 01 1984 Larry's well & pump Sunflower
date well completed firm name county well located

LANDOWNER: Harris Russell

Indianola Ms
(mailing address)

WELL LOCATION:
sec. 14 T 18 N/S R 3 E/W

1 S miles 1 E of Moorhead
(distance) (direction) (nearest town)

WELL PURPOSE: Fish Pond
(home, irrigation, municipal, industrial)

WELL COMPLETION DATA:

(1) diameter (inches) 16"
(2) total depth (feet) 106'
(3) static water level (feet) 30 below ~~above~~ top of ground.
(4) casing Steel (material), 66' (depth),
_____ (size) If telescope see back.
(5) screen 40' (length), 66' (depth to top)
16" (size), Steel (material)
(6) pump 60 (HP) 3000 (yield gpm)
Electric (type power)
(7) electric log No (yes or no)
_____ (organization running log)
(8) how well bottom plugged Steel Plate

DRILLERS REMARKS:

description of formations encountered	from	to
clay	0	30
Fine Sand	30	50
coarse Sand & gr	50	106

CODED

DEPT. OF NATURAL RESOURCES
BUREAU OF LAND & WATER RESOURCES
OCT - 2 1984
RECEIVED

If well telescopes please sketch and show depths.

GROUND LEVEL

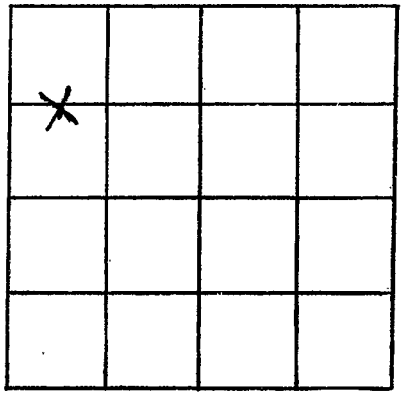

SECTION 14

Please indicate well location X.

ADDITIONAL INFORMATION

If more than one screen, show locations of each on sketch.