SUNFLOWER
S 33
8-26-81

MISSISSIPPI DEPARTMENT OF NATURAL RESOURCES

Bureau of Land and Water Resources
Southport Mall
P.O. Box 10631
Jackson, Mississippi 39209

WATER WELL DRILLERS LOG

CODED

8-26-81 19 — RYEN WELL + EBA. — Sunflower
date well completed — firm name — county well located

LANDOWNER:
R. D. MALLETTE
Indianola, MS.
(mailing address)

WELL LOCATION:
sec. 34 T. 17 (N) S R. 5 (E) W
6 miles (distance) W (direction) of Indola (nearest town)

WELL PURPOSE:
(home, (irrigation), municipal, industrial)

WELL COMPLETION DATA:

(1) diameter (inches) 16"
(2) total depth (feet) 103'
(3) static water level (feet) 22' below above top of ground.
(4) casing Steel (material), 63' (depth), 16" (size) If telescope see back.
(5) screen 40' (length), 63' (depth to top), 16" (size), Steel (material)
(6) pump 60 (HP) 3000 (yield gpm) Diesel (type power)
(7) electric log no (yes or no)
(organization running log)
(8) how well bottom plugged plate

DRILLERS REMARKS:

description of formations encountered	from	to
Clay		35
fine Sand	35	50
Sand + Gravel	50	103

CODED

DEPT. OF NATURAL RESOURCES
BUREAU OF LAND & WATER RESOURCES
SEP 16 1981
RECEIVED

If well telescopes please sketch and show depths.

GROUND LEVEL

If more than one screen, show locations of each on sketch.

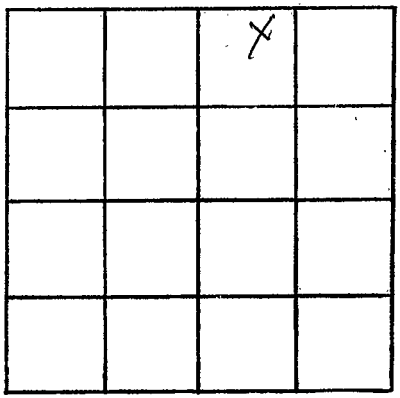

SECTION 34

Please indicate well location X.

ADDITIONAL INFORMATION