

T-27 T-20

9-26-64 WATER WELL DRILLERS LOG

**CODED**

T 20

Date: Sept. 26, 1964, Driller: Layne-Central Co. County: Leflore

(Name)

(1) Owner of Land: Town of Inverness  
(Name)

Inverness, Mississippi

(Address)

(2) Location: 1/4, 1/4, Sec. 3 T17R4

           miles            of             
(distance) (direction) (Nearest Town)

(3) Topography:             
(Hilly) (Flat) (Level)

(4) Purpose of Well: municipal  
(Domestic Irrigation  
Municipal, Industrial, Other)

Description & Color of Materials Sand, Clay, Red Clay, Shell, etc.	Thick- ness Feet	Depth Feet
soil	2	2
clay	33	35
coarse black sand	45	80
sand-stks coarse gravel	130	210
fine white sand	125	335
fine sand stks clay	131	466
sandy clay	29	495
clay	15	510
sand-clay stks	58	568
fine sand-stks clay	66	634
sand	102	736
clay	3	739

Information upon completion of well:

(1) Diameter 12 inches.

(2) Total Depth 739 feet.

(3) Water Level 21 feet below top of ground.

(4) Cased to 675', Size 12"

(5) Screen: Size 8", Length 60'

(6) Were any formations sealed against pollution?


yes,  no.

If YES depth of formation 675'

Why            required

Drillers Remarks:           

**CODED**

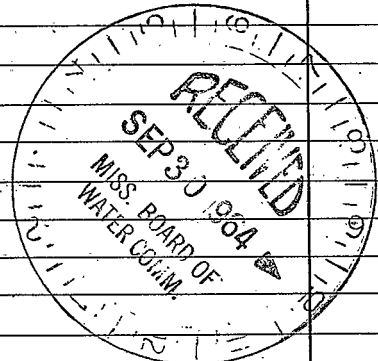

(Use Back Side)

Well No.





