TALLAHATCHIE
A17
7-16-71

MISSISSIPPI
BOARD OF WATER COMMISSIONERS
416 North State Street
Jackson, Mississippi 39201

WATER WELL DRILLERS LOG **CODED**

July 16 1971 — Pope Well Co. — Tallahatchie
date well completed — firm name — county well located

LANDOWNER:
Tom Smith
Enid, Miss
(mailing address)

WELL LOCATION:
sec. 12 T. 26 N. R. 2 E. W.
6 miles (distance) W (direction) of Enid (nearest town)

WELL PURPOSE: Home
(home, irrigation, municipal, industrial)

WELL COMPLETION DATA:

(1) diameter (inches) 4"
(2) total depth (feet) 231
(3) static water level (feet) 100 below above top of ground.
(4) casing PVC (material), 221' (depth), 4" (size) if telescope see back.
(5) screen 10' (length), 221' (depth to top), 4" (size), PVC & silica (material)
(6) pump 3/4 (HP) 10 (yield gpm)
elec (type power)
(7) electric log no (yes or no)
✓ (organization running log)
(8) how well bottom plugged PVC cap

DRILLERS REMARKS:

description of formations encountered	from	to
top soil	0	5
sand	5	20
gravel	20	60
sand & gravel	60	100
clay	100	140
sand & clay	140	231

CODED

OCT 12 1971
MISS. BD. OF WATER COMM.

If well telescopes please sketch and show depths.

GROUND LEVEL

If more than one screen, show locations of each on sketch.

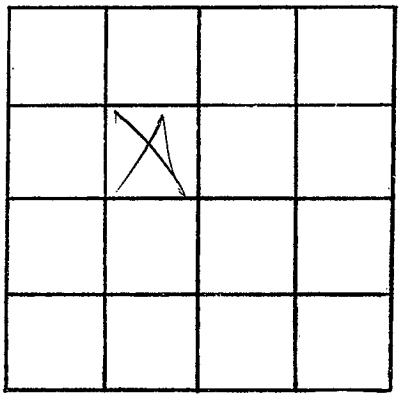

SECTION 12

Please indicate well location X.

ADDITIONAL INFORMATION