MISSISSIPPI DEPARTMENT OF NATURAL RESOURCES

Bureau of Land and Water Resources

P.O. Box 10631
Jackson, Mississippi 39209
WATER WELL DRILLERS LOG

COUNTY WELL LOCATED: Tallahatchie

WELL NUMBER: C 46 | CODED: ✓

PERMIT NUMBER:

NAME OF DRILLING FIRM: Powell Drl, Inc Clarksdale, MS

DATE WELL COMPLETED: 5/88

NAME & MAILING ADDRESS OF LANDOWNER: Ricky Parsons, Vance, MS

WELL LOCATION: SEC 2 TOWNSHIP 25 (N) RANGE 2 (E)

DISTANCE 2 Miles DIRECTION W of NEAREST TOWN Vance

OTHER LANDMARK:

WELL PURPOSE: Home, Irrigation, Municipal, Industrial, Fish Pond, etc.

PUMP DATA

PUMP TYPE (Circle One): Submersible, Turbine, Jet, Flowing Well, Other (Describe) _____

POWER TYPE (Circle One): Electric, Tractor, Diesel, Gasoline, Butane, Other (Describe) _____

Pump Capacity (GPM)	No. of Stages	Setting Depth
1200	3	50 FT.

PUMP TEST

Well yielded _____ GPM with a drawdown of _____ ft. after _____ hours of pumping

WELL DATA

Well Depth	Casing Diameter (In.)	Casing Length (Ft.)
110	12	70

Type of Casing	Hole Depth	Depth to Static Water Level
Steel	110	14

TYPE OF COMPLETION: (Circle One or More): Gravel Packed, Underreamed, Telescoped, Natural Development, Open Hole, Other (Describe) _____

Top of Lap Pipe or Reduction in Casing: FEET

IF TELESCOPED OR MORE THAN ONE SCREEN: USE BACK PAGE

LOG DATA

TYPE OF LOG RUN (Circle One): No Log Run, Electric, Gamma Ray, Density, Sonic, Neutron, Other (Describe) _____

Name of Organization Running Log:

GEOLOGIC DATA (Office Use Only)

Surface Elev.	Geologic Unit	Unit Thickness	Depth to Top
Subs. SWL	Date	Analysis	Aquifer Test

Driller's Remarks:

SCREEN DATA

Diameter - Inches	Length - Feet	Slot Size - Inches
12	40	030

Screen Type	Depth to Bottom - Feet
Steel	110

DESCRIPTION OF FORMATIONS ENCOUNTERED	FROM	TO
Clay	0	23
Coarse Sand	23	53
Gravel	53	110

FORMATIONS (continued) FROM TO

RECEIVED JUN 20 1988 Department of Natural Resources Bureau of Land & Water Resources

IF MORE SPACE IS NEEDED, USE BACK

If well telescopes please
sketch and show depths.

GROUND LEVEL

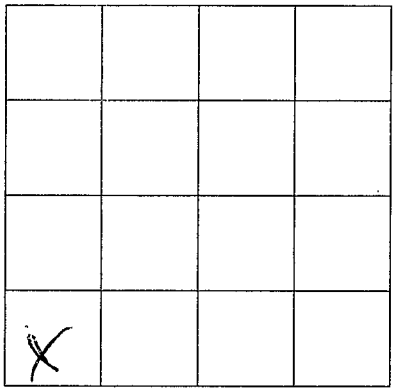

SECTION 2

Please indicate well location X.

ADDITIONAL INFORMATION

If more than one screen,
show location of each on sketch.