

TALLA, WATER WELL DRILLERS LOG

Zallakalekie

Date: 5-6-61 Driller: Joe P. Lipe County: Danette

(1) Owner of Land: Joe Carter
(Name)

Charleston, Miss
(Address)

(2) Location: 1/4, 1/4, Sec 24 T. 28 N. R. E
4 miles North, of Charleston
(distance) (direction) (Nearest Town)

(3) Topography: Hilly
(Hilly) (Flat) (Level)

(4) Purpose of Well: Municipal
(Domestic, Irrigation, Municipal, Industrial, Other)

Description & Color of Materials Sand, Clay, Red Clay, Shell, etc.	Thick- ness Feet	Depth Feet
Clay	0	20
Clay & gravel	20	50
Sand & gravel	50	75
White Sand	25	125
Upper sand	125	156

Information upon completion of well:

(1) Diameter 2 inches.

(2) Total Depth 156 feet.

(3) Water Level 140 feet below top of ground.

(4) Cased to 150, Size 2".


(5) Screen: Size 1/4, Length 6'.

(6) Were any formations sealed against pollution?
 _____ yes, _____ no.

If YES depth of formation _____

Why _____

Drillers Remarks: _____

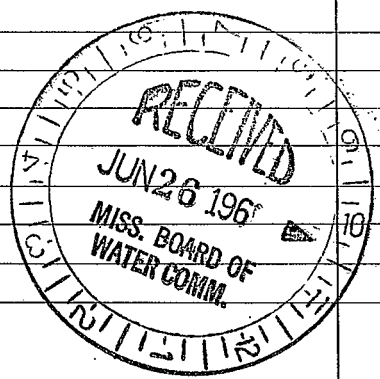

(Use Back Side)

Well No.










