MISSISSIPPI DEPARTMENT OF ENVIRONMENTAL QUALITY
Bureau of Land and Water Resources

P. O. Box 10631
Jackson, MS 39289-0631
WATER WELL DRILLERS LOG

COUNTY WELL LOCATED: Tallahatchie	
WELL NUMBER: F2007	CODED:
PERMIT NUMBER:	
NAME OF DRILLING FIRM: Lee Well Drilling Ms	
DATE WELL COMPLETED: 4/1/94	

NAME & MAILING ADDRESS OF LANDOWNER
JAMES Lewis Johnson
P.O. Box 41
Charleston, ms.

WELL LOCATION: SEC 28 TOWNSHIP 25 (N) S RANGE 2 (E) W

DISTANCE ½ Miles DIRECTION S of NEAREST TOWN Charleston

OTHER LANDMARK

WELL PURPOSE: (Home), Irrigation, Municipal, Industrial, Fish Pond, etc.

PUMP DATA

PUMP TYPE (Circle One): (Submersible), Turbine, Jet, Flowing Well, Other (Describe)

POWER TYPE (Circle One): (Electric), Tractor, Diesel, Gasoline, Butane, Other (Describe) H/P ½

Pump Capacity (GPM)	No. of Stages	Setting Depth
10		40 FT.

PUMP TEST

Well yielded 12 GPM with a drawdown of ft. after hours of pumping

WELL DATA

Well Depth	Casing Diameter (In.)	Casing Length (Ft.)
47	4"	37

Type of Casing	Hole Depth	Depth to Static Water Level
PVC	47	20

TYPE OF COMPLETION: (Circle One or More): (Gravel Packed), Underreamed, Telescoped, Natural Development, Open Hole, Other (Describe)

Top of Lap Pipe or Reduction in Casing FEET

IF TELESCOPED OR MORE THAN ONE SCREEN: USE BACK PAGE

LOG DATA

TYPE OF LOG RUN (Circle One): (No Log Run), Electric, Gamma Ray, Density, Sonic, Neutron, Other (Describe)

Name of Organization Running Log

GEOLOGIC DATA (Office Use Only)

Surface Elev.	Geologic Unit	Unit Thickness	Depth to Top
Subs. SWL	Date	Analysis	Aquifer Test
Driller's Remarks			

RECEIVED
APR 18 1994
Dept. of Environmental Quality
Office of Land & Water Resources

SCREEN DATA

Diameter - Inches	Length - Feet	Slot Size - Inches
4"	10	.013"

Screen Type	Depth to Bottom - Feet
WW PVC	47

DESCRIPTION OF FORMATIONS ENCOUNTERED	FROM	TO	FORMATIONS (Continued)	FROM	TO
17' of topsoil 2' clay	0	20			
Clay to 39 ft, the	20	47			
rest 8' sand					
			IF MORE SPACE IS NEEDED, USE BACK		

If well telescopes please
sketch and show depths.

GROUND LEVEL

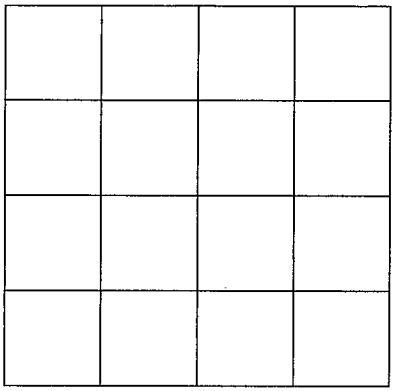

SECTION _____

Please indicate well location X.

ADDITIONAL INFORMATION

If more than one screen,
show location of each on sketch.