MISSISSIPPI DEPARTMENT OF ENVIRONMENTAL QUALITY
Bureau of Land and Water Resources

P. O. Box 10631
Jackson, MS 39289-0631
WATER WELL DRILLERS LOG

COUNTY WELL LOCATED: Tallahatchie	PERMIT NUMBER:
WELL NUMBER: T2005 / CODED:	NAME OF DRILLING FIRM: Layne Central
DATE WELL COMPLETED: 7/7/94	

NAME & MAILING ADDRESS OF LANDOWNER
Fischer Farm Services (Sunpower)
P.O. Box 926
Aberdeen, MS

WELL LOCATION: SEC S17 TOWNSHIP T24 N RANGE R1 W

DISTANCE 2 Miles DIRECTION East of NEAREST TOWN Webb

OTHER LANDMARK: Near Hwy 321 & Hwy 32 Intersection

WELL PURPOSE: Home, Irrigation, Municipal, Industrial, Fish Pond, etc.
Irrigation

PUMP DATA

PUMP TYPE (Circle One): ~~Submersible~~, Turbine, ~~Jet~~, ~~Flowing Well~~, Other (Describe)

POWER TYPE (Circle One): ~~Electric~~, ~~Tractor~~, Diesel, ~~Gasoline~~, ~~Butane~~, Other (Describe) H/P 40

Pump Capacity (GPM)	No. of Stages	Setting Depth
2000	1	60 FT.

PUMP TEST: Not Performed

Well yielded _____ GPM with a drawdown of _____ ft. after _____ hours of pumping

WELL DATA

Well Depth	Casing Diameter (In.)	Casing Length (Ft.)
115'	16"	65'

Type of Casing	Hole Depth	Depth to Static Water Level
PVC	115'	15'6"

TYPE OF COMPLETION: (Circle One or More): Gravel Packed, Underreamed, Telescoped, Natural Development, Open Hole, Other (Describe)

Top of Lap Pipe or Reduction in Casing: N/A FEET

IF TELESCOPED OR MORE THAN ONE SCREEN: USE BACK PAGE

SCREEN DATA

Diameter - Inches	Length - Feet	Slot Size - Inches
16"	50'	.050

Screen Type	Depth to Bottom - Feet
PVC	115'

LOG DATA

TYPE OF LOG RUN (Circle One): No Log Run, ~~Electric~~, ~~Gamma Ray~~, ~~Density~~, ~~Sonic~~, ~~Neutron~~, Other (Describe)

Name of Organization Running Log

GEOLOGIC DATA (Office Use Only)

Surface Elev.	Geologic Unit	Unit Thickness	Depth to Top
Subs. SWL	Date	Analysis	Aquifer Test

Driller's Remarks

DESCRIPTION OF FORMATIONS ENCOUNTERED	FROM	TO	FORMATIONS (Continued)	FROM	TO
Clay	0	30			
Sand	30	45			
Sand Gravel	45	108			
Boulders	108	115			
Rock	115				
			IF MORE SPACE IS NEEDED, USE BACK		

RECEIVED
SEP 14 1994
Dept. of Environmental Quality
Office of Land & Water Resources

If well telescopes please
sketch and show depths.

GROUND LEVEL

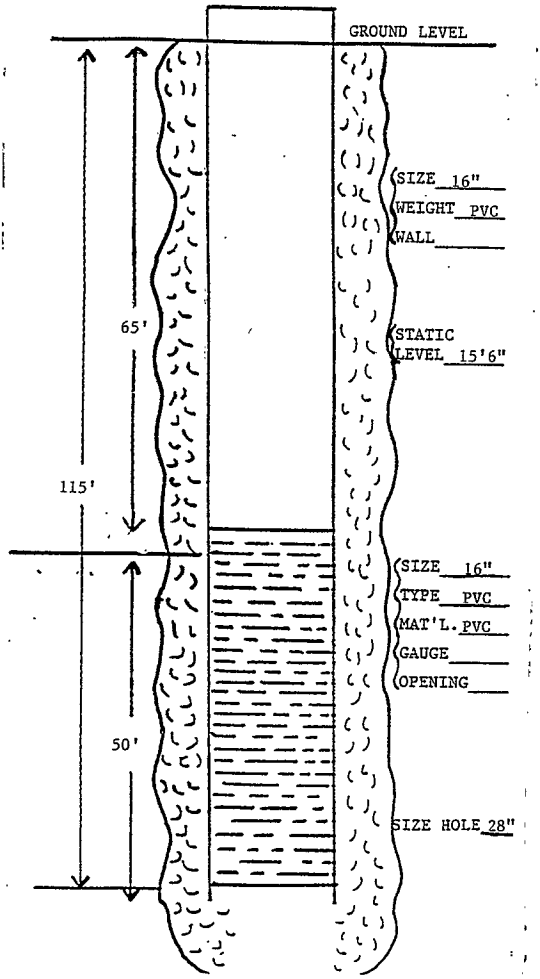

If more than one screen,
show location of each on sketch.

	X		

SECTION 17

Please indicate well location X.

ADDITIONAL INFORMATION