MISSISSIPPI DEPARTMENT OF ENVIRONMENTAL QUALITY
Office of Land and Water Resources

P. O. Box 10631
Jackson, MS 39289-0631
WATER WELL DRILLERS LOG

COUNTY WELL LOCATED: Tallahatchie	
WELL NUMBER: L-23	CODED:
PERMIT NUMBER: MS-GW-38835	
NAME OF DRILLING FIRM: Schudco Ltd	
DATE WELL COMPLETED: Oct 28, 2000	

NAME & MAILING ADDRESS OF LANDOWNER
Gill McMahen
PAT McMAHEN
LeLand MS 38756

WELL LOCATION: SEC 19 TOWNSHIP 24 (N/S) RANGE 2 (E/W)

DISTANCE ____ Miles DIRECTION ____ of NEAREST TOWN Paynes

OTHER LANDMARK

WELL PURPOSE: Home, Irrigation, Municipal, Industrial, Fish Pond, etc.
Duck pond

PUMP DATA

PUMP TYPE (Circle One): Submersible, Turbine, Jet, Flowing Well, Other (Describe) ____

POWER TYPE (Circle One): Electric, Tractor, Diesel, Gasoline, Butane, Other (Describe) ____ H/P ____

Pump Capacity (GPM)	No. of Stages	Setting Depth
		FT.

PUMP TEST
Well yielded ____ GPM with a drawdown of ____ ft. after ____ hours of pumping

WELL DATA

Well Depth	Casing Diameter (In.)	Casing Length (Ft.)
90	10	70
Type of Casing	**Hole Depth**	**Depth to Static Water Level**
pve	90	12 ft

TYPE OF COMPLETION: (Circle One or More): Gravel Packed, Underreamed, Telescoped, Natural Development, Open Hole, Other (Describe) ____

WELL GROUTED TO A DEPTH OF ____ FEET
Type Grout (circle one): Cement, Bentonite, or Mix

LOG DATA

TYPE OF LOG RUN (Circle One): No Log Run, Electric, Gamma Ray, Density, Sonic, Neutron, Other (Describe) ____

Name of Organization Running Log

GEOLOGIC DATA (Office Use Only)

Surface Elev.	Geologic Unit	Unit Thickness	Depth to Top
Subs. SWL	Date	Analysis	Aquifer Test

Driller's Remarks
phone - 662 473-2333

SCREEN DATA

Diameter - Inches	Length - Feet	Slot Size - Inches
10	20	.035
Screen Type		**Depth to Bottom - Feet**
pve		90

Top of Lap Pipe or Reduction in Casing
FEET — IF TELESCOPED OR MORE THAN ONE SCREEN: USE BACK PAGE

DESCRIPTION OF FORMATIONS ENCOUNTERED	FROM	TO
Clay	0	16
course sand + p-gravel	16	40
med to course sand	40	50
med sand	50	67
course sand + p-gravel	67	88
med sand	88	90

FORMATIONS (Continued)	FROM	TO

IF MORE SPACE IS NEEDED, USE BACK

RECEIVED
JUL 0 6 2001
YMD JOINT WATER MANAGEMENT DISTRICT

If well telescopes please
sketch and show depths.

GROUND LEVEL

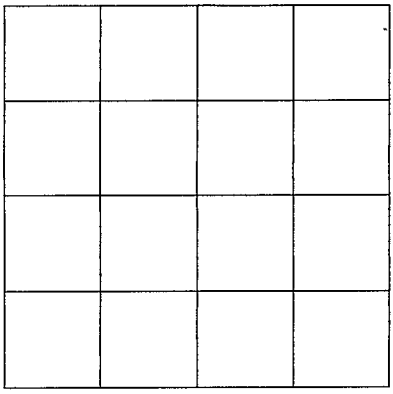

SECTION _____

Please indicate well location X.

ADDITIONAL INFORMATION

If more than one screen,
show location of each on sketch.