Tallahatchie
M 38
7-18-75

MISSISSIPPI
BOARD OF WATER COMMISSIONERS
416 North State Street
Jackson, Mississippi 39201

CODED

WATER WELL DRILLERS LOG

7-18 1975 Lipe Well Co. Tallahatchie
date well completed — firm name — county well located

LANDOWNER:
G.E. Holland
Charleston Miss.
(mailing address)

WELL LOCATION:
sec. 27 T 24 (N) S R 3 (E) W 150
8 miles S.E. of Charleston
(distance) (direction) (nearest town)

WELL PURPOSE:
(home, irrigation, municipal, industrial)

WELL COMPLETION DATA:

(1) diameter (inches) 4
(2) total depth (feet) 165
(3) static water level (feet) 90 below above top of ground.
(4) casing PVC (material), 155 (depth),
4 (size) if telescope see back.
(5) screen 10 (length), 155 (depth to top)
4 (size), PVC (material)
(6) pump 3/4 (HP) 10 (yield gpm)
elec. (type power)
(7) electric log no (yes or no)
no (organization running log)
(8) how well bottom plugged PVC plug

DRILLERS REMARKS:

description of formations encountered	from	to
Top soil	0	20
Red sand	20	40
" "	40	60
Pea gravel	60	80
Gravel	80	100
Sand	100	120
Clay and sand	120	140
White sand	140	165

CODED

RECEIVED
AUG 5 1975
MISS. BD. OF WATER COMMISS.

If well telescopes please sketch and show depths.

GROUND LEVEL

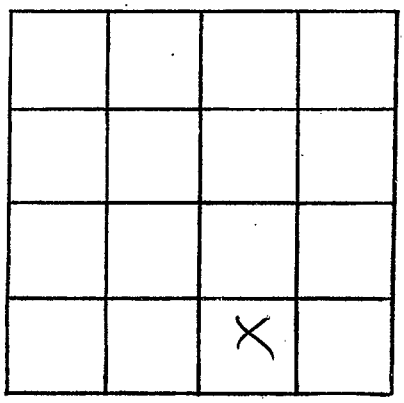

SECTION 27

Please indicate well location X.

ADDITIONAL INFORMATION

If more than one screen, show locations of each on sketch.