TALLAHATCHIE
M 2003
5-13-77

150

MISSISSIPPI
BOARD OF WATER COMMISSIONERS
416 North State Street
Jackson, Mississippi 39201

WATER WELL DRILLERS LOG

5-13 1977 Lipe Well Co. Tallahatchie
date well completed — firm name — county well located

LANDOWNER: New Hope Presbyterian Church, Charleston MS.
(mailing address)

WELL LOCATION:
sec. 21 T 24 (N/S) R 3 (E/W)
8 miles S. E. of Charleston
(distance) (direction) (nearest town)

WELL PURPOSE: Church (home, irrigation, municipal, industrial)

WELL COMPLETION DATA:

(1) diameter (inches) 4
(2) total depth (feet) 170
(3) static water level (feet) 80 below/above top of ground.
(4) casing PVC (material), 160 (depth), 4 (size) If telescope see back.
(5) screen 10 (length), 160 (depth to top), 4 (size), PVC (material)
(6) pump 3/4 (HP) 10 (yield gpm) elec. (type power)
(7) electric log Non (yes or no) Non (organization running log)
(8) how well bottom plugged PVC cap

DRILLERS REMARKS:

description of formations encountered	from	to
Top Soil	0	20
Clay	20	40
Sand	40	60
Gravel	60	80
red sand	80	100
clay	100	120
sand and clay	120	140
" " "	140	160
good sand	160	170

RECEIVED
JUN 2 1977
MISS. BD. OF WATER COMMS.

If well telescopes please sketch and show depths.

GROUND LEVEL

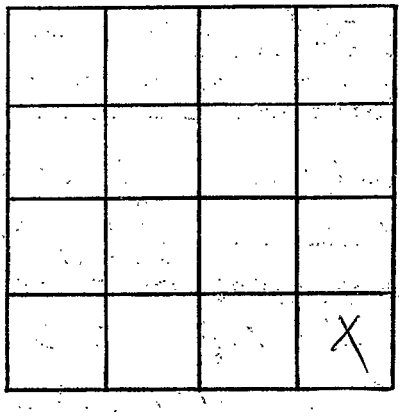

SECTION 21

Please indicate well location X.

ADDITIONAL INFORMATION

If more than one screen, show locations of each on sketch.