MISSISSIPPI DEPARTMENT OF ENVIRONMENTAL QUALITY
Office of Land and Water Resources

P. O. Box 10631
Jackson, MS 39289-0631

WATER WELL DRILLERS LOG

COUNTY WELL LOCATED: Tallahatchie	
WELL NUMBER: N-2008	CODED:
DATE WELL COMPLETED: 9-19-99	
PERMIT NUMBER:	
NAME OF DRILLING FIRM: Bryant Well & Pump Ser. 0-639	

NAME & MAILING ADDRESS OF LANDOWNER
Drilled For Luckett
Pump & Well
Dublin, MS (662) 624-2398

WELL LOCATION	SEC	TOWNSHIP	RANGE
Glendora	25	23 (N) S	2 E (W)

DISTANCE	DIRECTION	NEAREST TOWN
5 Miles	Southwest of	Glendora

OTHER LANDMARK
Located on Hunting Club land

WELL PURPOSE: Home, Irrigation, Municipal, Industrial, Fish Pond, etc.
Camp house

PUMP DATA

PUMP TYPE (Circle One): Submersible, Turbine, Jet, Flowing Well, Other (Describe) _____

POWER TYPE (Circle One): Electric, Tractor, Diesel, Gasoline, Butane, Other (Describe) _____ H/P _____

Pump Capacity (GPM)	No. of Stages	Setting Depth
		FT.

PUMP TEST set by Luckett
Well yielded Pump & Well GPM with a drawdown of _____ ft. after _____ hours of pumping

WELL DATA

Well Depth	Casing Diameter (In.)	Casing Length (Ft.)
95'	4"	85'

Type of Casing	Hole Depth	Depth to Static Water Level
160 PVC	95'	34'

TYPE OF COMPLETION: (Circle One or More): Gravel Packed, Underreamed, Telescoped, Natural Development, Open Hole, Other (Describe) _____

WELL GROUTED TO A DEPTH OF 25 FEET
Type Grout (circle one): Cement, Bentonite, or Mix

LOG DATA

TYPE OF LOG RUN (Circle One): No Log Run, Electric, Gamma Ray, Density, Sonic, Neutron, Other (Describe) _____

Name of Organization Running Log

GEOLOGIC DATA (Office Use Only)

Surface Elev.	Geologic Unit	Unit Thickness	Depth to Top
Subs. SWL	Date	Analysis	Aquifer Test

Driller's Remarks

Top of Lap Pipe or Reduction in Casing
FEET — IF TELESCOPED OR MORE THAN ONE SCREEN: USE BACK PAGE

SCREEN DATA

Diameter - Inches	Length - Feet	Slot Size - Inches
4"	10'	0.13

Screen Type	Depth to Bottom - Feet
SCH-40 PVC	85' to 95'

DESCRIPTION OF FORMATIONS ENCOUNTERED	FROM	TO	FORMATIONS (Continued)	FROM	TO
Clay	0	20			
Clay & sand	20	40			
coarse sand & gravel	40	60			
gravel	60	80			
gravel	80	95'			
			IF MORE SPACE IS NEEDED, USE BACK		

If well telescopes please
sketch and show depths.

GROUND LEVEL

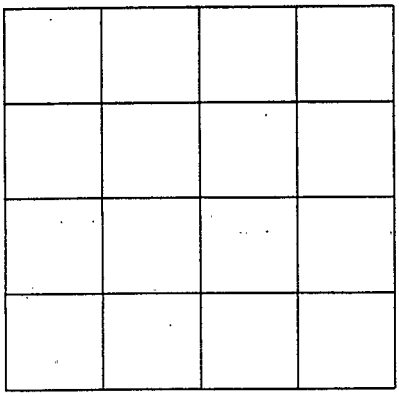

SECTION _____

Please indicate well location X.

ADDITIONAL INFORMATION

If more than one screen,
show location of each on sketch.