Tallahatchie
Ø 33
7-5-70

MISSISSIPPI
BOARD OF WATER COMMISSIONERS
416 North State Street
Jackson, Mississippi 39201

CODED

WATER WELL DRILLERS LOG

7/5/70 19 — date well completed
BUTANE GAS CO — firm name
GREENWOOD MISS.
TALLAHATCHIE CO — county well located

LANDOWNER: THODEST WILSON
FISH FARM
MINTER CITY MISS
(mailing address)

WELL LOCATION:
sec. 31 T 23 N R 1 W
NW/4 - SE/4 NE/4
miles (distance) (direction) of (nearest town)

WELL PURPOSE: INDUSTRIAL.
(~~home, irrigation, municipal~~, industrial)

WELL COMPLETION DATA:

(1) diameter (inches) 4
(2) total depth (feet) 778
(3) static water level (feet) 1 ~~below~~ above top of ground.
(4) casing STEEL (material), 415 (depth),
3 (size) if telescope see back.
(5) screen 42 (length), (depth to top)
(size), STAINLESS STEEL (material)
(6) pump 5 (HP) 80 (yield gpm)
ELEC (type power)
(7) electric log YES (yes or no)
MISSISSIPPI GEOLOGICAL SURVEY (organization running log)
FILE NO 03
(8) how well bottom plugged
LEAD WOOD PLUG

DRILLERS REMARKS:

description of formations encountered	from	to
CLAY	0	24
SAND	24	69
SAND + GRAVEL	69	119
SANDY CLAY	119	213
ROCK	213	214
SANDY SHALE	214	313
HARD SHALE	313	395
ROCK	395	399
SHALE & ROCK ST.	399	430
SANDY SHALE	430	730
SAND	730	751
SHALE	751	756
SAND	756	777
SHALE	777	863
HARD SHALE	863	973
SANDY SHALE	973	1040
HARD SHALE	1040	1080
SANDY SHALE	1080	1145
HARD SHALE	1145	1228
ROCK	1228	1229
SHALE	1229	1330

778

JUL 27 1970

MISS. BD. OF WATER COMMRS

If well telescopes please sketch and show depths.

NW-/4 - SEC/4- NE/4

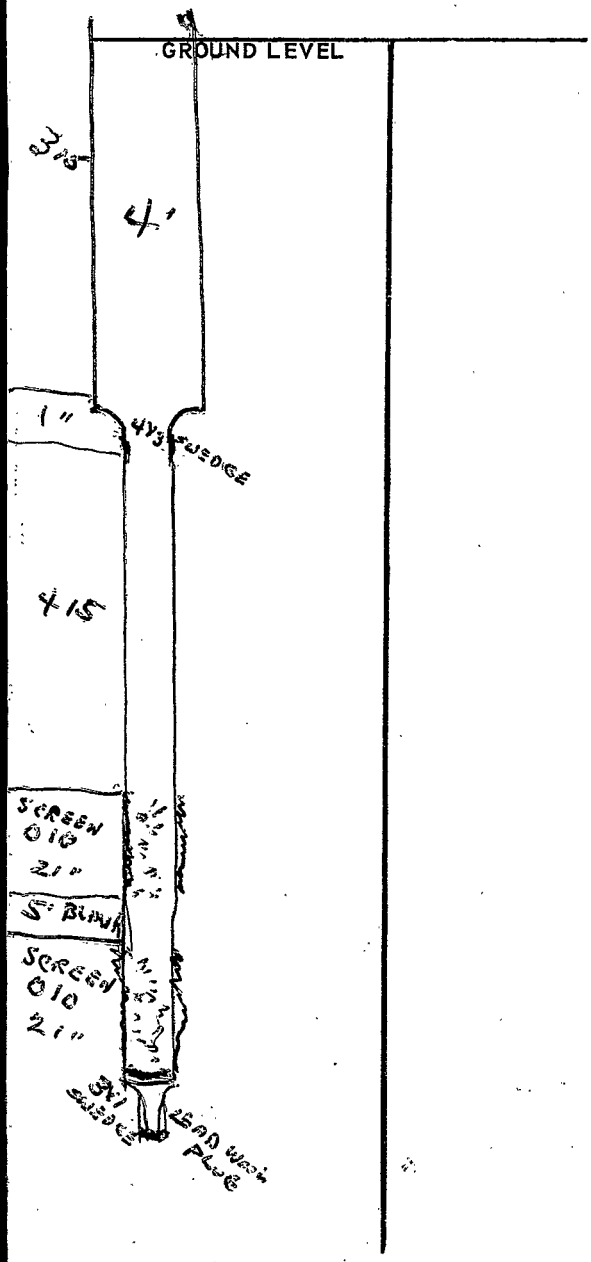

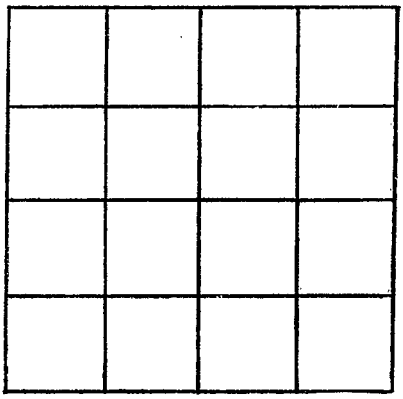

SECTION 31

Please indicate well location X.

ADDITIONAL INFORMATION

If more than one screen, show locations of each on sketch.