TALLAHATCHIE

Grenada
G-27 Q2000
7-19-75
GW 2148

MISSISSIPPI BOARD OF WATER COMMISSIONERS
416 North State Street
Jackson, Mississippi 39201

CODED

WATER WELL DRILLERS LOG

July 19, 1975 — date well completed

Sunjin Corp. J. W. Fennell — firm name

Grenada ~~Tallahatchie~~ — county well located

LANDOWNER: J. W. Fennell

Philipp, Miss. 38950

RT 1 Box 86 658-4974

(mailing address)

WELL LOCATION:

sec. 31 T 23 N R 2 E

23X 156

5 miles East of Philipp

(distance) (direction) (nearest town)

WELL PURPOSE: irrigation

(home, irrigation, municipal, industrial)

WELL COMPLETION DATA:

(1) diameter (inches) 16"

(2) total depth (feet) 92'

(3) static water level (feet) _____ below above top of ground.

(4) casing Steel (material), 32' (depth), 16" (size) if telescope see back.

(5) screen 60' (length), 32' (depth to top), 16" (size), Steel (material)

(6) pump 60 (HP) 2500-3000 (yield gpm) engine (type power)

(7) electric log no (yes or no)

(organization running log)

(8) how well bottom plugged steel plate

DRILLERS REMARKS:

description of formations encountered	from	to
Clay	0	12'
Fine sand	12	25'
Coarse sand	25	72'
Gravel & Coarse sand	72	92'
Fine sand		92'

CODED

RECEIVED
AUG 6 1975
MISS. BD. OF WATER COMM.

If well telescopes please sketch and show depths.

GROUND LEVEL

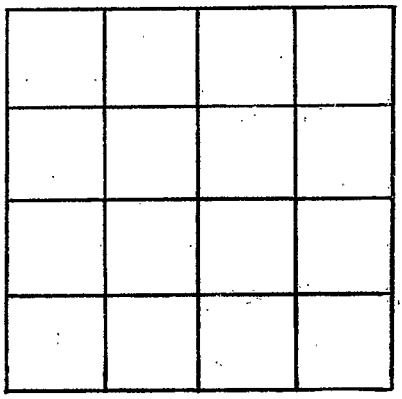

SECTION _____

Please indicate well location X.

ADDITIONAL INFORMATION

If more than one screen, show locations of each on sketch.