TATE
Book
7-3-79

MISSISSIPPI
BOARD OF WATER COMMISSIONERS
416 North State Street
Jackson, Mississippi 39201

WATER WELL DRILLERS LOG

7-3- 19 79 Hicks Well Co TATE
date well completed — firm name — county well located

LANDOWNER: New Gardner Baptist Church
(mailing address)

WELL LOCATION:
sec. 13 T 4 N (S) R 7 E (W)
Sowell Bro.
(distance) miles (direction) of (nearest town)

WELL PURPOSE: home
(home, irrigation, municipal, industrial)

WELL COMPLETION DATA:
(1) diameter (inches) 4 in
(2) total depth (feet) 140
(3) static water level (feet) _____ below above top of ground.
(4) casing Plastic (material), 140 (depth),
_____ (size) if telescope see back.
(5) screen 7 ft (length), 133 (depth to top)
4 in (size), Sowel (material)
(6) pump 1/2 (HP) 10 (yield gpm)
220 (type power)
(7) electric log No (yes or no)
_____ (organization running log)
(8) how well bottom plugged Cap

DRILLERS REMARKS:

description of formations encountered	from	to
Red Clay	0	20
Red Sand	20	80
White Sand	80	140

Miss. Board of Water Comm.
JUL 12 1979
RECEIVED

If well telescopes please sketch and show depths.

GROUND LEVEL

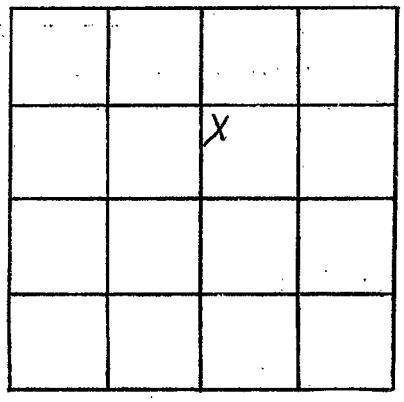

SECTION 13

Please indicate well location X.

ADDITIONAL INFORMATION

If more than one screen, show locations of each on sketch.