MISSISSIPPI DEPARTMENT OF ENVIRONMENTAL QUALITY
Bureau of Land and Water Resources

P. O. Box 10631
Jackson, MS 39289-0631
WATER WELL DRILLERS LOG

COUNTY WELL LOCATED	TATE
WELL NUMBER	B
CODED	
PERMIT NUMBER	
NAME OF DRILLING CONTRACTOR	HICKS WELL CO. RT. 1 BOX 157 SENATOBIA, MS 38668
DATE WELL COMPLETED	8-19-92

NAME & MAILING ADDRESS OF LANDOWNER
Chester Massey
RT. 3 BOX 521
Coldwater, MS

WELL LOCATION: SEC 26 TOWNSHIP 4 (N) (S) RANGE 7 (E) (W)

DISTANCE 6 Miles DIRECTION N/E of NEAREST TOWN Coldwater

OTHER LANDMARK

WELL PURPOSE: (Home) Irrigation, Municipal, Industrial, Fish Pond, etc.

PUMP DATA

PUMP TYPE (Circle One): (Submersible) Turbine, Jet Flowing Well, Other (Describe) _____

POWER TYPE (Circle One): (Electric) Tractor, Diesel, Gasoline, Butane, Other (Describe) _____ H/P 1/2

Pump Capacity (GPM)	No. of Stages	Setting Depth
9 BC	9	60 FT.

PUMP TEST

Well yielded _____ GPM with

a drawdown of _____ ft.

after _____ hours of pumping

WELL DATA

Well Depth	Casing Diameter (In.)	Casing Length (Ft.)
110	4"	100

Type of Casing	Hole Depth	Depth to Static Water Level
PVC	110	40

TYPE OF COMPLETION: (Circle One or More): (Gravel Packed) Underreamed, Telescoped, Natural Development, Open Hole, Other (Describe) _____

Top of Lap Pipe or Reduction in Casing FEET

IF TELESCOPED OR MORE THAN ONE SCREEN: USE BACK PAGE

LOG DATA

TYPE OF LOG RUN (Circle One): No Log Run, Electric, Gamma Ray, Density, Sonic, Neutron, Other (Describe) _____

Name of Organization Running Log

GEOLOGIC DATA (Office Use Only)

Surface Elev.	Geologic Unit	Unit Thickness	Depth to Top
Subs. SWL	Date	Analysis	Aquifer Test

Driller's Remarks

SCREEN DATA

Diameter - Inches	Length - Feet	Slot Size - Inches
4"	10'	.013

Screen Type	Depth to Bottom - Feet
PVC	13

DESCRIPTION OF FORMATIONS ENCOUNTERED	FROM	TO
Red Sand & Clay	0	60
W. Sand	60	110

FORMATIONS (Continued)	FROM	TO

IF MORE SPACE IS NEEDED, USE BACK

RECEIVED
OCT 22 1992
Dept. of Environmental Quality
Bureau of Land & Water Resources

If well telescopes please
sketch and show depths.

GROUND LEVEL

If more than one screen,
show location of each on sketch.

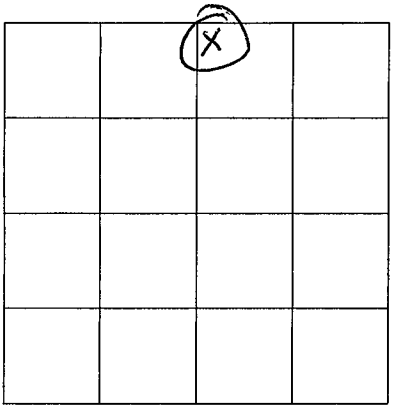

SECTION _____

Please indicate well location X.

ADDITIONAL INFORMATION