MISSISSIPPI DEPARTMENT OF ENVIRONMENTAL QUALITY
Bureau of Land and Water Resources

P. O. Box 10631
Jackson, MS 39289-0631
WATER WELL DRILLERS LOG

COUNTY WELL LOCATED	Tate
WELL NUMBER	B
CODE	
PERMIT NUMBER	
NAME OF DRILLING FIRM	HICKS WELL CO. RT. 1 BOX 157 SENATOBIA, MS 38668
DATE WELL COMPLETED	10-26-92

NAME & MAILING ADDRESS OF LANDOWNER
Johnnie James Const. Co
Rt 4 Box 239
Coldwater, ms 38618

WELL LOCATION: SEC 32 TOWNSHIP 4 N (S) RANGE 8 E (W)

DISTANCE 5 Miles DIRECTION W of NEAREST TOWN Coldwater

OTHER LANDMARK

WELL PURPOSE: (Home), Irrigation, Municipal, Industrial, Fish Pond, etc.

PUMP DATA

PUMP TYPE (Circle One): (Submersible), Turbine, Jet Flowing Well, Other (Describe)

POWER TYPE (Circle One): (Electric) Tractor, Diesel, Gasoline, Butane, Other (Describe) H/P 7½

Pump Capacity (GPM)	No. of Stages	Setting Depth
10	12	140 FT.

PUMP TEST

Well yielded 10 GPM with a drawdown of _____ ft. after _____ hours of pumping

WELL DATA

Well Depth	Casing Diameter (In.)	Casing Length (Ft.)
180	4"	170

Type of Casing	Hole Depth	Depth to Static Water Level
PVC	180	105

TYPE OF COMPLETION: (Circle One or More): (Gravel Packed), Underreamed, Telescoped, Natural Development, Open Hole, Other (Describe)

Top of Lap Pipe or Reduction in Casing FEET

IF TELESCOPED OR MORE THAN ONE SCREEN: USE BACK PAGE

SCREEN DATA

Diameter - Inches	Length - Feet	Slot Size - Inches
4"	10'	013

Screen Type	Depth to Bottom - Feet
PVC	101

LOG DATA

TYPE OF LOG RUN (Circle One): No Log Run, Electric, Gamma Ray, Density, Sonic, Neutron, Other (Describe)

Name of Organization Running Log

GEOLOGIC DATA (Office Use Only)

Surface Elev.	Geologic Unit	Unit Thickness	Depth to Top
Subs. SWL	Date	Analysis	Aquifer Test

Driller's Remarks

DESCRIPTION OF FORMATIONS ENCOUNTERED	FROM	TO
R. sand	0	20
gravel	20	60
Clay	60	140
w. sand	140	180

FORMATIONS (Continued)	FROM	TO

RECEIVED
MAR 22 1993
Dept. of Environmental Quality
Office of Land & Water Resources

IF MORE SPACE IS NEEDED, USE BACK

If well telescopes please
sketch and show depths.

GROUND LEVEL

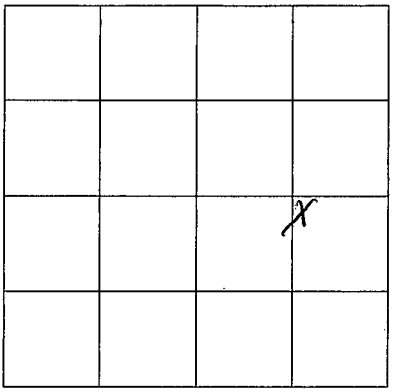

SECTION _____

Please indicate well location X.

ADDITIONAL INFORMATION

If more than one screen,
show location of each on sketch.