CODED

Tate
C41
5-69

MISSISSIPPI
BOARD OF WATER COMMISSIONERS
416 North State Street
Jackson, Mississippi 39201

WATER WELL DRILLERS LOG

5-24 1969 Bob Smith Tate
date well completed — firm name — county well located

LANDOWNER: Massey
Independence Miss
(mailing address)

WELL LOCATION: NW NW
sec. 4 T 4 N (S) R 6 E (W)
4½ miles S of Coxburg
(distance) (direction) (nearest town)

WELL PURPOSE: Home
(home, irrigation, municipal, industrial)

WELL COMPLETION DATA:

(1) diameter (inches) 4
(2) total depth (feet) 168
(3) static water level (feet) 100 (below) above top of ground.
(4) casing Plastic (material), 168 (depth),
_____ (size) if telescope see back.
(5) screen 20 (length), 148 (depth to top)
4 (size), Plastic (material)
(6) pump ¾ (HP) 15 (yield gpm)
Elec. (type power)
(7) electric log no (yes or no)
_____ (organization running log)
(8) how well bottom plugged plugged

DRILLERS REMARKS: good drilling

description of formations encountered	from	to
Top Soil	0	5
red clay	5	30
red gravel	30	50
white sand	50	168

AUG 11 1969
MISS. BD. OF WATER COMM.

If well telescopes please sketch and show depths.

GROUND LEVEL

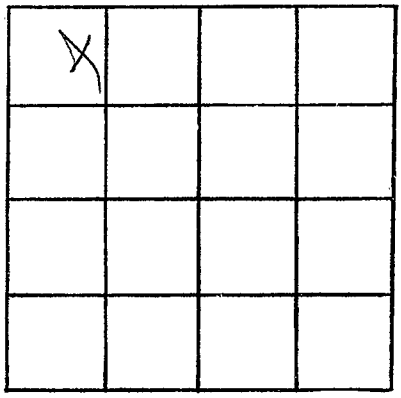

SECTION 4

Please indicate well location X.

ADDITIONAL INFORMATION

If more than one screen, show locations of each on sketch.