TATE
C 122
7-28-72

MISSISSIPPI
BOARD OF WATER COMMISSIONERS
416 North State Street
Jackson, Mississippi 39201

CODED

WATER WELL DRILLERS LOG

7-28- 1972 — date well completed
Bob Smith — firm name
Tate — county well located

LANDOWNER: Billy Berry
Sherley
(mailing address)

WELL LOCATION:
sec. 7 T 4 N (S) R 6 E (W)
6 (distance) miles NE (direction) of Coldwater (nearest town)

WELL PURPOSE: Home
(home, irrigation, municipal, industrial)

WELL COMPLETION DATA:
(1) diameter (inches) 4
(2) total depth (feet) 140
(3) static water level (feet) 58 below above top of ground.
(4) casing Plastic (material), 140 (depth),
_____ (size) if telescope see back.
(5) screen 20 (length), 120 (depth to top)
4 (size), Plastic (material)
(6) pump 1/2 (HP) 10 (yield gpm)
Elec (type power)
(7) electric log no (yes or no)
_____ (organization running log)
(8) how well bottom plugged Plugged

DRILLERS REMARKS:

description of formations encountered	from	to
clay dirt		18
gravel	10	20
white sand	20	140

CODED

If well telescopes please sketch and show depths.

GROUND LEVEL

If more than one screen, show locations of each on sketch.

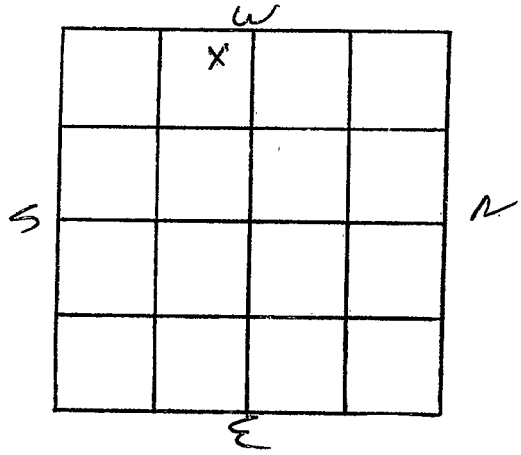

SECTION 7

Please indicate well location X.

ADDITIONAL INFORMATION