TATE
C 141
10-10-73

MISSISSIPPI
BOARD OF WATER COMMISSIONERS
416 North State Street
Jackson, Mississippi 39201

CODED

WATER WELL DRILLERS LOG

10-10 1973 Harris Bros. Tate
date well completed — firm name — county well located

LANDOWNER: Albert Lowell
Rt. 3
Coldwater
(mailing address)

WELL LOCATION:
sec. 7 T 4 N (S) R 6 E (W)
1 1/4 miles W of Sardine
(distance) (direction) (nearest town)

WELL PURPOSE: home
(home, irrigation, municipal, industrial)

WELL COMPLETION DATA:
(1) diameter (inches) 4
(2) total depth (feet) 120
(3) static water level (feet) 80 below above top of ground.
(4) casing Plastic (material), 113 (depth),
4 (size) if telescope see back.
(5) screen 7 (length), 113 (depth to top)
OOK (size), Plastic (material)
(6) pump 3/4 (HP) 7 (yield gpm)
elec. (type power)
(7) electric log no (yes or no)
(organization running log)
(8) how well bottom plugged solid

DRILLERS REMARKS:

description of formations encountered	from	to
top soil	0	15
pea gravel	15	40
Clay & sand	40	105
Coarse sand	105	120

RECORDED

If well telescopes please sketch and show depths.

GROUND LEVEL

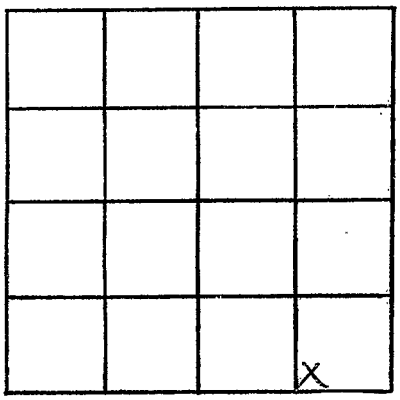

SECTION 7

Please indicate well location X.

ADDITIONAL INFORMATION

If more than one screen, show locations of each on sketch.