

Late  
C 169  
2-10-75

MISSISSIPPI  
 BOARD OF WATER COMMISSIONERS  
 416 North State Street  
 Jackson, Mississippi 39201 **CODED**  
**WATER WELL DRILLERS LOG**

2-10 1975 Harris Bros Late  
 date well completed firm name county well located

LANDOWNER: J.P. Miller  
Rt. 3  
Coldwater  
 (mailing address)

description of formations encountered	from	to
<u>top soil</u>	<u>0</u>	<u>20</u>
<u>clay + sand</u>	<u>20</u>	<u>115</u>
<u>Coarse sand</u>	<u>115</u>	<u>130</u>

WELL LOCATION:  
 sec. 34 T. 4 N. R. 6 E. 15E  
1 miles S of Independence  
 (distance) (direction) (nearest town)

WELL PURPOSE: home  
 (home, irrigation, municipal, industrial)

**CODED**

WELL COMPLETION DATA:

(1) diameter (inches) 4

(2) total depth (feet) 130

(3) static water level (feet) 80  below  above top of ground.

(4) casing Plastic, 123  
 (material) (depth)  
4 If telescope see back.  
 (size)

(5) screen 7, 123  
 (length) (depth to top)  
008, Plastic  
 (size) (material)


(6) pump 3/4 7  
 (HP) (yield gpm)  
elec.  
 (type power)

(7) electric log no  
 (yes or no)

(organization running log)

(8) how well bottom plugged solid

DRILLERS REMARKS:

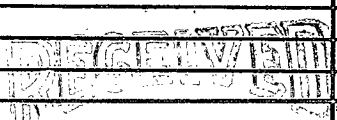


OCT 10 1975

BOARD OF WATER COMMISSIONERS

If well telescopes please sketch and show depths.

GROUND LEVEL

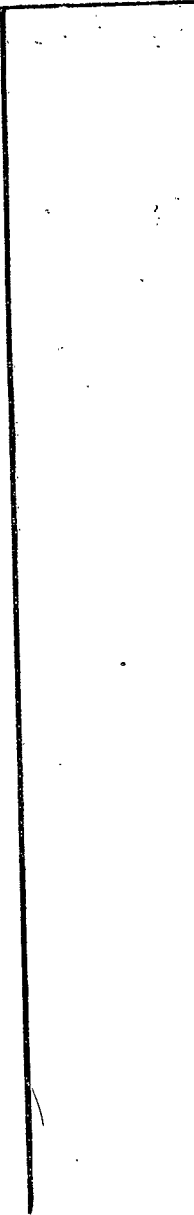

X			

SECTION 35

Please indicate well location X.

ADDITIONAL INFORMATION

If more than one screen,  
show locations of each on sketch.