State Well Report
Part 1

Mississippi Department of Environmental Quality
Office of Land and Water Resources
P.O. Box 10631
Jackson, MS 39289-0631
(601)961-5210
(601)354-6938 (fax)

County: TATE
Permit #:
Driller: BOB SMITH
Date drilling completed: 9-19-07

For Office Use Only:
Aquifer:
Well #: C-265
L.S. Elevation:
E-log #:

State Law requires that this report be prepared by the driller in detail and filed with the Department within 30 days of completion of drilling of the well.

Well Owner Information

Owner Name: LARRY DAY
Mailing Address: LOT 5 SPRINGWOOD
CORNWATER, MS 38618
City State Zip Code
Telephone No. 901) 351-8257

Well Location

Latitude: ° ' " Longitude: ° ' "
Method of Lat/Long (circle one): Conventional Survey, USGS quad, Hand-held GPS, Survey-grade GPS
¼ ¼ Sec 017 Twn T4S Rng R6W
Distance 9 Miles Direction W of Nearest Town WAKEFIELD

Well Data

Purpose of Well (circle one): Home Industrial Public Supply Irrigation Fish Culture Other:
Date well drilling started: 9-19-07 Date well drilling completed: 9-19-07
If flowing, method of flow regulation: Valve Other (describe)
Static Water Level: 80 feet above or below (circle one) land surface Date measured: 9-19-07
Method of Measurement (circle one): steel tape electric tape air line other:
Hole depth: 110 Well depth: 110 Well grouted to a depth of 10 feet
Type of grout (circle one): Cement Bentonite Mix
Casing length: 100 feet Casing diameter: 4 inches Type of casing: PVC
Screen length: 10 feet Screen diameter: 4 inches Type of screen: PVC
Screen slot size: 13 MOS inches Setting depth: From 100 feet to 110 feet
Type of completion (circle all applicable): Gravel packed Undergrouted Telescoped Open hole Natural Development
Other (describe): WASHED SAND
Top of lap pipe or reduction in casing: feet. If telescoped or more than one screen, describe on back of page
Logs run (circle all applicable): No log run Electric Gamma Ray Density Sonic Neutron Other:
Name of organization running log(s):

I certify that the well was drilled, constructed, and completed in accordance with all applicable requirements of the Mississippi Department of Environmental Quality and/or the Mississippi Department of Health regulations and state laws.

BOB SMITH 0-645
Print Name of Water Well Contractor and License No. Signature of Water Well Contractor

C-265

If well telescopes please sketch below and show depths.

Ground Level

Description of Formations Encountered	From	To
Top Soil	0	5
Brown Clay	5	18
Gravel	18	26
White Clay + Sand	26	72
White Sand	72	110

If more than one screen, show location of each on sketch

Sketch the property layout and include the following: 1) the well location; 2) any permanent structures on the property that may aid in locating the well; 3) any roads, power lines, or other items that may aid in locating the property and the well; 4) indicate direction.

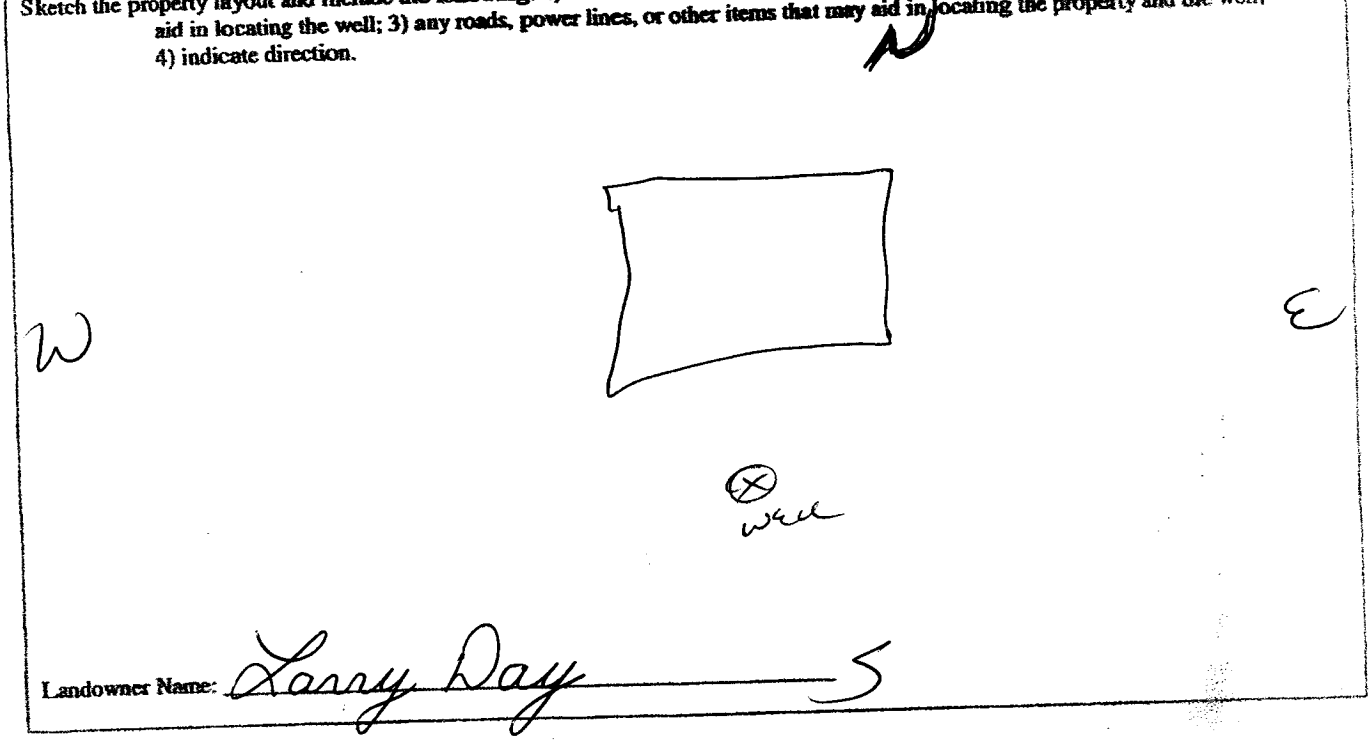

Landowner Name: Larry Day

Signature of Water Well Contractor

RECEIVED
OCT 09 2007
BY: OLWR

STATE WELL REPORT
Part 2

Pump Installer's Completion Report
Mississippi Department of Environmental Quality
Office of Land and Water Resources
P.O. Box 10631
Jackson, MS 39289-0631
(601)961-5210
(601)354-6938 (fax)

County: Tate
Permit #:
Driller: Bob Smith
Date completed: 9-19-07

For Office Use Only:
Aquifer:
Well #: C-265
Elevation:

This report should be prepared by the pump installer in detail and filed with the Department within 30 days of the installation of pump.

Well Owner Information

Owner Name: Larry Dix
Mailing Address: Lot 5 Symphony
Olive Branch MS 38618
City State Zip Code
Telephone No. (901) 351-8257

Well Location

Latitude: Longitude:
Method of Lat/Long (circle one): Conventional Survey, USGS quad, Hand-held GPS, Survey-grade GPS
___ ¼ ___ ¼ Sec 21 Twn T4S Rng R6W
Distance 4 Miles Direction W of Nonpareil
Nearest Town

Pump Type
Circle one

Air Lift, Jet, (Submersible), Bucket, Piston, Turbine, Centrifugal, Rotary, Flowing Well
Other (specify):
Date Pump Installed: 9-19-07
Rated Pump Capacity: ___ Gallons Per Minute

Power Type
Circle one

Diesel Engine, Gasoline Engine, Natural Gas, (Electric Motor), Hand, Tractor PTO, Windmill, Other (specify):
Horse Power Rating of Motor: 3/4
Setting Depth: 90 feet
Number of Stages: 11

Pump Test Data

Date Well Tested: 9-19-07
Static Water Level (A): 80 Feet Below Land Surface
Pumping Water Level (B): 84 Feet Below Land Surface
Drawdown [(B) – (A)]: 4 Feet Below Land Surface
Test Pumping Rate: 14 Gallons Per Minute
Duration of Pump Test (minimum 4 hours): ___ hours

Method of Measuring Water Level
Circle one

Air Line, (Electric Measuring Line), Steel Tape
Other (specify):
For flowing well, measured shut in head: ___ feet
Well yielded 14 GPM with a drawdown of 4 feet after ___ hours of pumping

I HEREBY CERTIFY that the above statements are true to the best of my knowledge.

Bob Smith 0645
Print Name of Pump Installer and License No. (if applicable)

Signature of Pump Installer

RECEIVED
OCT 09 2007
BY: OLWR