Tate
C 2022
5/3/76

15E

MISSISSIPPI
BOARD OF WATER COMMISSIONERS
416 North State Street
Jackson, Mississippi 39201

WATER WELL DRILLERS LOG

5-3-1976 Bob Smith Well Serv Tate
date well completed — firm name — county well located

LANDOWNER: Q. L. Waddell
Coldwater, Miss.
(mailing address)

WELL LOCATION:
sec. 30 T 4 N (S) R 6 E (W)
0 miles 0 of Pontotoc
(distance) (direction) (nearest town)

WELL PURPOSE:
(home, irrigation, municipal, industrial)

WELL COMPLETION DATA:

(1) diameter (inches) 4
(2) total depth (feet) 135
(3) static water level (feet) 105 below ~~above~~ top of ground.
(4) casing Plastic (material), 135 (depth),
(size) If telescope see back.
(5) screen 10 (length), 125 (depth to top)
4 (size), Plastic (material)
(6) pump 1/2 (HP) 10 (yield gpm)
Elec (type power)
(7) electric log (yes or no)
(organization running log)
(8) how well bottom plugged

DRILLERS REMARKS:

description of formations encountered	from	to
Top soil	0	5
red clay	5	30
gravel + sand	30	55
Fine sand	55	100
Coarse sand	100	135

RECEIVED
SEP 20 1976
MISS. BD. OF WATER COMM.

If well telescopes please sketch and show depths.

GROUND LEVEL

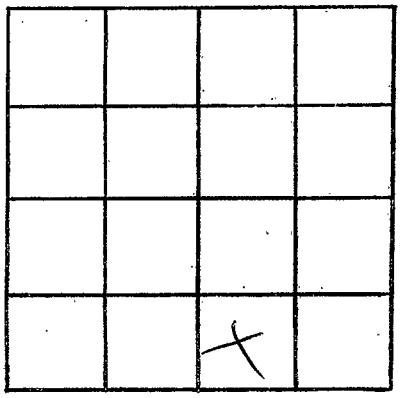

SECTION _____

Please indicate well location X.

ADDITIONAL INFORMATION

If more than one screen, show locations of each on sketch.