MISSISSIPPI DEPARTMENT OF NATURAL RESOURCES

Bureau of Land and Water Resources

P.O. Box 10631
Jackson, Mississippi 39209
WATER WELL DRILLERS LOG

COUNTY WELL LOCATED	~~Panola~~ TATE
WELL NUMBER	C
CODED	
PERMIT NUMBER	
NAME OF DRILLING FIRM	Hicks Well Co
DATE WELL COMPLETED	5-14-89

NAME & MAILING ADDRESS OF LANDOWNER
Otha Wright
Rt. 2
Coldwater, Ms 38618

WELL LOCATION: SEC 20 TOWNSHIP 4 N (S) RANGE 6 E (W)

DISTANCE 1½ Miles DIRECTION N NEAREST TOWN of Bomentown

OTHER LANDMARK

WELL PURPOSE (Home), Irrigation, Municipal, Industrial, Fish Pond, etc.

PUMP DATA

PUMP TYPE (Circle One): (Submersible), Turbine, Jet Flowing Well, Other (Describe)

POWER TYPE (Circle One): (Electric), Tractor, Diesel, Gasoline, Butane, Other (Describe) H/P ½

Pump Capacity (GPM)	No. of Stages	Setting Depth
10 gpm	9	120 FT.

PUMP TEST

Well yielded _____ GPM with a drawdown of _____ ft. after _____ hours of pumping

WELL DATA

Well Depth	Casing Diameter (In.)	Casing Length (Ft.)
120	4"	110

Type of Casing	Hole Depth	Depth to Static Water Level
PVC	120	70

TYPE OF COMPLETION: (Circle One or More): (Gravel Packed), Underreamed, Telescoped, Natural Development, Open Hole, Other (Describe)

Top of Lap Pipe or Reduction in Casing FEET

IF TELESCOPED OR MORE THAN ONE SCREEN: USE BACK PAGE

LOG DATA

TYPE OF LOG RUN (Circle One): No Log Run, (Electric), Gamma Ray, Density, Sonic, Neutron, Other (Describe)

Name of Organization Running Log

GEOLOGIC DATA (Office Use Only)

Surface Elev.	Geologic Unit	Unit Thickness	Depth to Top
Subs. SWL	Date	Analysis	Aquifer Test

Driller's Remarks

SCREEN DATA

Diameter - Inches	Length - Feet	Slot Size - Inches
4"	10	013

Screen Type	Depth to Bottom - Feet
PVC	120'

DESCRIPTION OF FORMATIONS ENCOUNTERED	FROM	TO
R. Clay	0	10
Clay + Sand	10	75
white sand	75	120

FORMATIONS (Continued)	FROM	TO

IF MORE SPACE IS NEEDED, USE BACK

RECEIVED
JUN 8 1989
Department of Natural Resources
Bureau of Land & Water Resources

If well telescopes please
sketch and show depths.

GROUND LEVEL

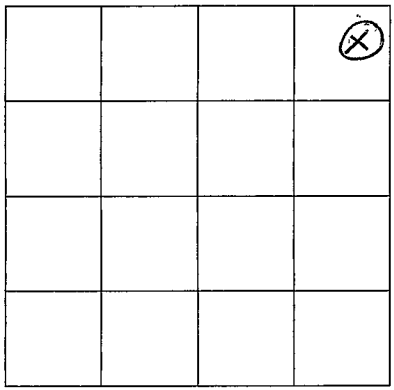

SECTION _____

Please indicate well location X.

ADDITIONAL INFORMATION

If more than one screen,
show location of each on sketch.