County: Tate

Permit #:

Driller: James W. Mason

Date drilling completed: 6-26-07

State Well Report

Part 1 – Driller's Log

Mississippi Department of Environmental Quality
Office of Land and Water Resources
P.O. Box 10631
Jackson, MS 39289-0631
(601)961-5210
(601)354-6938 (fax)

For Office Use Only:

Aquifer:

Well #: D-136

L. S. Elevation:

E-log #:

State Law requires that this report be prepared by the license holder responsible for the work and filed with the Department at the above address within 30 days of completion of drilling of the well or borehole.

Information on Well Owner
(Landowner if borehole is not for a water well)

Owner Name: William Davis

Mailing Address: 2434 wall hill rd.

Coldwater MS 38618
City State Zip Code

Telephone No. (662) 292-1840

Well or Borehole Location

Latitude: 34 ° 42 ' 780 " Longitude: 89 ° 43 ' 962 "
47 58

Method of Lat/Long (circle one): Conventional Survey, USGS quad, (Hand-held GPS,) Survey-grade GPS

NW ¼ NE ¼ Sec 28 Twn 4S Rng 5W

Distance 2 Miles Direction SE of Nearest Town Wakefield

Well / Borehole Data

Date drilling started: 6-26-07 Date drilling completed: 6-26-07 Hole depth: 155' Hole diameter: 6 3/4

Location of the source of any surface water used for drilling: NA

Method of dosing and volume of Chlorine used in drilling and development: NA

Logs run (circle all applicable): (No log run) Electric Gamma Ray Density Sonic Neutron Other:

Name of organization running log(s): NA

Purpose of borehole (check one): Water Well ✓ Geotechnical/Geological Investigation___ Ground Source Heat Pump___

Seismic Survey___ Other (*describe*)

If drilling is not related to water well construction, skip the remainder of this block

Purpose of Well (check one): Home ✓ Industrial___ Public Supply___ Irrigation___ Fish Culture___ Other:

If a flowing well, method of flow regulation: Valve NA Other (describe)

Static Water Level: 72 feet above or (below) (circle one) land surface Date measured: 6-27-07

Method of Measurement (circle one) steel tape electric tape air line other: string weight.

Well depth: 155 Well grouted to a depth of 10 feet Type of grout (circle one): Neat Cement (Bentonite) Mix

Casing length: 145 feet Casing diameter: 4 inches Type of casing: PVC

Screen length: 10 feet Screen diameter: 4 inches Type of screen: PVC

Screen slot size: .010 inches Setting depth: From 145 feet to 155 feet

Type of completion (circle all applicable): (Gravel packed) Underreamed Telescoped Open hole Natural Development

Other (describe): NA

Top of lap pipe or reduction in casing: NA feet. ***If telescoped or more than one screen, describe on next page***

Form: OLWR-SWR-1A

D136

The sketch below only required for water wells

If well telescopes, show depths on sketch.

Ground Level

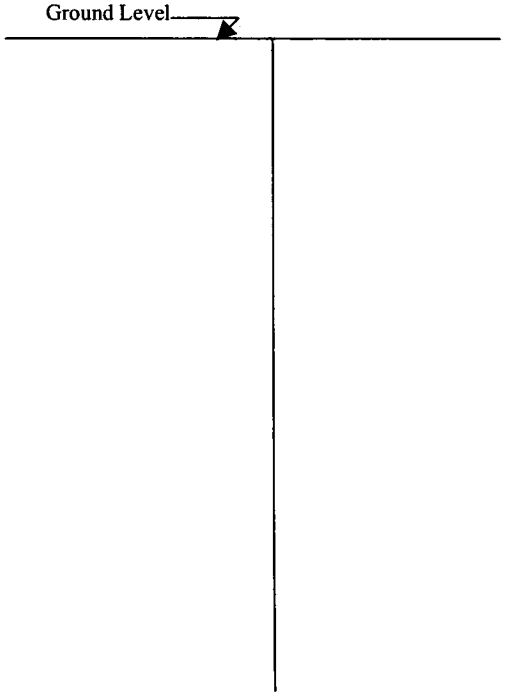

If more than one screen, show location of each on sketch

Description of formations encountered must be provided for all wells and boreholes, unless specifically exempted by regulations

Description of Formations Encountered	From (depth)	To (depth)
clay dirt	Ground Level	15
red sand	15	30
white sand	30	60
white clay	60	75
Blue clay	75	130
white sand	130	155

Sketch the property layout and include the following: 1) the well location; 2) any permanent structures on the property that may aid in locating the well; 3) any roads, power lines, or other items that may aid in locating the property and the well; 4) a north arrow.

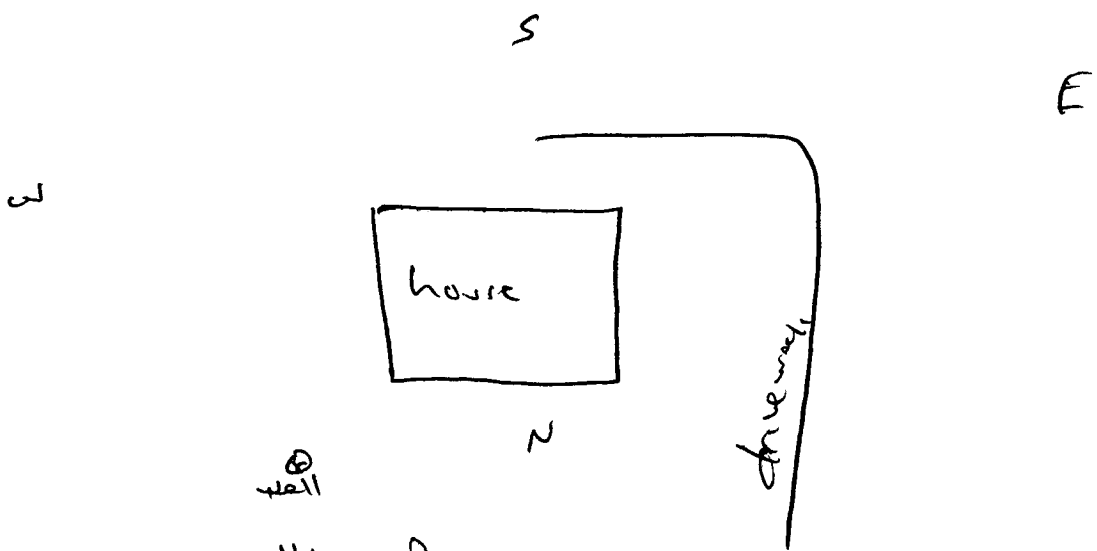

Landowner Name: William Davis.

Form: OLWR-SWR-1A

I certify that the well/borehole was drilled, constructed, and completed in accordance with all applicable requirements of the Mississippi Department of Environmental Quality and the Mississippi Department of Health regulations, if applicable, and state laws.

James W. Mason. 0620 | 7-24-07 | James W. Mason

Print Name of Responsible Licensee and License No. | **Date** | **Signature of Licensee**

STATE WELL REPORT

Part 2

Pump Installer's Completion Report

Mississippi Department of Environmental Quality
Office of Land and Water Resources
P.O. Box 10631
Jackson, MS 39289-0631
(601)961-5210
(601)354-6938 (fax)

County: Tate
Permit #:
Driller: Jones w. Mason
Date completed: 6-27-07
Copy information from block on Part 1

For Office Use Only:
Aquifer:
Well #: D136
Elevation:

This part of the report must be completed by a licensed water well contractor or a licensed pump installer. A copy of Part 1 of the report must be attached and both parts filed with the Department at the above address within 30 days of well completion.

Well Owner Information

Owner Name: William Davis.
Mailing Address: 2434 wall hill rd
Coldwater (City) MS (State) 38618 (Zip Code)
Telephone No. (662) 292-1840

Well Location

Latitude: 34.42.780 Longitude: 89.43.962
Method of Lat/Long (check one): Conventional Survey 47 58, USGS quad___, Hand-held GPS ✓, Survey-grade GPS___
NW ¼ NE ¼ Sec 28 T 4S R 5W
Distance 2 Miles Direction SE of Nearest Town Waterfield

Pump Type (Circle one)

Air Lift | Jet | (Submersible)
Bucket | Piston | Turbine
Centrifugal | Rotary | Flowing Well
Other (specify):
Date Pump Installed: 6-27-07
Rated Pump Capacity: 12 Gallons Per Minute

Power Type (Circle one)

Diesel Engine | Gasoline Engine | Natural Gas
(Electric Motor) | Hand | Tractor PTO
Windmill | Other (specify):
Horse Power Rating of Motor: 3/4
Setting Depth: 100 feet
Number of Stages: 11

Pump Test Data

Date Well Tested: 6-27-07
Static Water Level (A): 72 Feet Below Land Surface
Pumping Water Level (B): NA Feet Below Land Surface
Drawdown [(B) – (A)]: NA Feet Below Land Surface
Test Pumping Rate: 12 Gallons Per Minute
Duration of Pump Test (minimum 4 hours): 24 hours

Method of Measuring Water Level (Circle one)

Air Line | Electric Measuring Line | Steel Tape
Other (specify): String weight
For flowing well, measured shut in head: NA feet
Well yielded 12 GPM with a drawdown of
No feet after 24 hours of pumping

I HEREBY CERTIFY that the above statements are true to the best of my knowledge.

Jones w. Mason 0-620
Print Name of Pump Installer and License No. (if applicable)

Signature of Pump Installer

Form: OLWR-SWR-1B