County: Tate

Permit #:

Driller: Jones W. Mason

Date drilling completed: 10-2-19

STATE WELL REPORT

Part 1

Driller's Log

Mississippi Department of Environmental Quality
Office of Land and Water Resources
P.O. Box 2309
Jackson, MS 39225-2309
(601)961-5210
(601)360-0535 (fax)

For Office Use Only:

Well #: D 178

Aquifer:

E-Log #:

elev 365

State Law requires that this report be prepared by the license holder responsible for the work and filed with the Department at the above address within 30 days of completion of drilling of the well or borehole.

Well Owner Information
(Landowner if borehole is not for a water well)

Owner Name: Silo homes

Mailing Address: 122 whitetail
lot 11 deerfield

Coldwater MS 38618
City State Zip Code

Telephone No. (901) 409-5109

Well or Borehole Location

Latitude: 34°45'08.44"N Longitude: 89°45'51.76"W

Method of Lat/Long (*check one*): Conventional Survey_____,

USGS quad_____, Hand-held GPS ✓, Survey-grade GPS_____

SW ¼ NE ¼, Sec 7 T 4S R 5W

1/2 Miles NE of New garden
(*Distance*) (*Direction*) (*Nearest Town*)

Well / Borehole Data

Date drilling started: 10-2-19 Date drilling completed: 10-2-19 Hole depth: 150 Hole diameter: 7"

Location of the source of any surface water used for drilling: NA

Method of dosing and volume of Chlorine used in drilling and development: 50 ppm and greater

Logs run (*circle all applicable*): (No log run) Electric Gamma Ray Density Sonic Neutron Other:

Name of organization running log(s): NA

Purpose of borehole (*circle one*): (Water Well) Geotechnical/Geological Investigation Ground Source Heat Pump

Seismic Survey Other (*describe*)

If drilling is not related to water well construction, skip the remainder of this block

Purpose of Well (*circle all applicable*): (Home) Industrial Public Supply Irrigation Fish Culture

Other (*describe*):

If a flowing well, method of flow regulation: Valve NA Other (*describe*)

Static Water Level: 72 feet [above or (below)] land surface Date measured: 10-2-19
(*circle one*)

Method of measurement (*circle one*): Steel tape Electric tape Air line Other (*describe*): String w/ weight

Well depth: 150 Well grouted to a depth of: 50 feet Type of grout (*circle one*): Neat Cement (Bentonite) Mix

Casing length: 130 feet Casing diameter: 4 inches Type of casing: PVC

Screen length: 20 feet Screen diameter: 4 inches Type of screen: PVC

Screen slot size: 010 inches Setting depth: From 130 feet to 150 feet

Type of completion (*circle all applicable*): (Gravel packed) Underreamed Open hole Natural Development

Other (*describe*): NA

Top of lap pipe or reduction in casing: _____ feet

If telescoped or more than one screen, describe on next page

RECEIVED
OCT 04 2019
BY OLWR

County: Tate

Permit #:

For Office Use Only:

Well #: D178

The sketch below only required for water wells

If well telescopes, show depths on sketch.

Ground Level

If more than one screen, show location of each on sketch

Description of formations encountered must be provided for all wells and boreholes, unless specifically exempted by regulations

Description of Formations Encountered	From (*depth*)	To (*depth*)
clay dirt	Ground level	15
Gravel	15	70
white clay	70	75
gravel	75	85
white clay	85	90
white sand	90	150

Sketch the property layout and include the following:

1) the well location
2) any permanent structures on the property that may aid in locating the well
3) any roads, power lines, or other items that may aid in locating the property and the well
4) north arrow

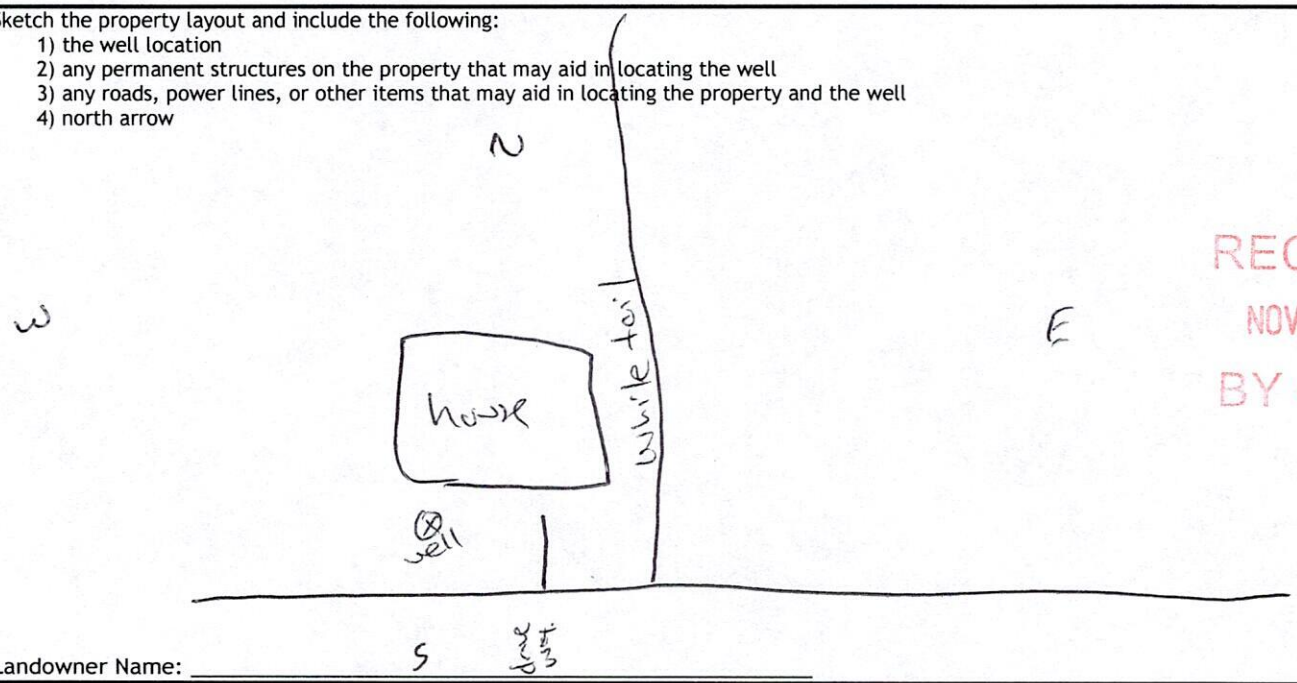

Landowner Name:

RECEIVED
NOV 01 2019
BY OLWR

I HEREBY CERTIFY that the well/borehole was drilled, constructed, and completed in accordance with all applicable requirements of the Mississippi Department of Environmental Quality and the Mississippi Department of Health regulations, if applicable, and state laws.

Jones W. Mason O-620	10-28-19	Jones W. Mason
Print Name of Responsible Licensee and License No.	Date	Signature of Licensee

Form: OLWR-SWR-1A (*4/13*)

STATE WELL REPORT

County: Tate

Permit #:

Driller: Jones W. Mason

Date completed: 10-2-19

Copy information from block on Part 1

Part 2

Pump Installer's Completion Report

Mississippi Department of Environmental Quality
Office of Land and Water Resources
P.O. Box 2309
Jackson, MS 39225-2309
(601)961-5210
(601) 360-0535 (fax)

For Office Use Only:

Well #: D178

Aquifer:

This part of the report must be completed by a licensed water well contractor or a licensed pump installer. A copy of Part 1 of the report must be attached and both parts filed with the Department at the above address within 30 days of well completion.

Well Owner Information

Owner Name: Silo homes

Mailing Address: 122 white tail

lot 11 deerfield

Coldwater MS 38618
City State Zip Code

Telephone No. (901) 409-5109

Well Location

Latitude: 34°45'08.44" N Longitude: 89°45'51.76" W

Method of Lat/Long (*check one*): Conventional Survey____, USGS quad____, Hand-held GPS ✓, Survey-grade GPS____

SW ¼ NE ¼, Sec 7 T 4S R 5W

1/2 Miles NE of New Garden
(*Distance*) (*Direction*) (*Nearest Town*)

Pump Type (*circle one*)

Submersible Turbine Air Lift Centrifugal Flowing Well Jet Piston Rotary Other (*describe*):

Date Pump Installed: 10-2-19 Rated Pump Capacity: 10 Gallons Per Minute

Is This Pump (*circle one*): New Repaired Replacement

Power Type (*circle one*)

Electric Diesel Gasoline Natural Gas Tractor PTO Windmill Other (*describe*):

Horse Power Rating of Motor: 3/4 Setting Depth: 100 feet Number of Stages: 8

Pump Test Data for Non Flowing Well

Date Well Tested: 10-2-19 Duration of Pump Test (*minimum 4 hours*): 24 hours

Static Water Level (A): 72 Feet Below Land Surface Pumping Water Level (B): N/A Feet Below Land Surface

Drawdown [(B) - (A)]: N/A Feet Below Land Surface Test Pumping Rate: 10 Gallons Per Minute

Method of measurement (*circle one*): Steel tape Electric tape Air line Other (*describe*): String / weight

Pump Test Data for Flowing Well

Measured shut in head: N/A feet.

Well yielded 10 GPM with a drawdown of N/A feet after 24 hours of pumping

Meter Installation

RECEIVED NOV 01 2019 BY OLWR

Meter Manufacturer: N/A Meter Serial Number: N/A

Meter Model Number/Name: N/A Type of Meter: N/A

Totalizer Register Unit and Multiplier Factor (AF x .001, gal x 1000, etc): N/A

Installation Date: N/A Meter installed by: N/A

Is This Meter (*circle one*): New Repaired Replacement

Important: By submitting the above information you are certifying that this meter was installed to manufacturer standards. For agricultural wells, a list of approved meters is on the MDEQ website.

I HEREBY CERTIFY that the above statements are true to the best of my knowledge.

Jones W. Mason 0-620 | 10-28-19 | Jones W. Mason
Print Name of Pump Installer and License No. (*if applicable*) | Date | Signature of Pump Installer

Form: OLWR-SWR-1B (*4/13*)