MISSISSIPPI DEPARTMENT OF NATURAL RESOURCES

Bureau of Land and Water Resources

P.O. Box 10631
Jackson, Mississippi 39209
WATER WELL DRILLERS LOG

COUNTY WELL LOCATED	Yalobusha
WELL NUMBER	D
CODED	
	2021
DATE WELL COMPLETED	9-9-87
PERMIT NUMBER	
NAME OF DRILLING FIRM	HICKS WELL COMPANY
	RT. 1 - BOX 157 SENATOBIA, MISS.

NAME & MAILING ADDRESS OF LANDOWNER

Christine Jenkins
Rt 4
Coldwater, MS 38618

WELL LOCATION: SEC 17 TOWNSHIP 4 N S RANGE 5 E W

DISTANCE 2 Miles DIRECTION NE of NEAREST TOWN Bert

OTHER LANDMARK

WELL PURPOSE: Home, Irrigation, Municipal, Industrial, Fish Pond, etc.

PUMP DATA

PUMP TYPE (Circle One): Submersible, Turbine, Jet Flowing Well, Other (Describe) _____

POWER TYPE (Circle One): Electric, Tractor, Diesel, Gasoline, Butane, Other (Describe) _____

Pump Capacity (GPM)	No. of Stages	Setting Depth
10	7	120 FT.

PUMP TEST

Well yielded _____ GPM with a drawdown of _____ ft. after _____ hours of pumping

WELL DATA

Well Depth	Casing Diameter (In.)	Casing Length (Ft.)
155'	4"	125'
Type of Casing	**Hole Depth**	**Depth to Static Water Level**
PVC	155'	100'

TYPE OF COMPLETION: (Circle One or More): Gravel Packed, Underreamed, Telescoped, Natural Development, Open Hole, Other (Describe) PVC Cap

Top of Lap Pipe or Reduction in Casing FEET

IF TELESCOPED OR MORE THAN ONE SCREEN: USE BACK PAGE

LOG DATA

TYPE OF LOG RUN (Circle One): No Log Run, Electric, Gamma Ray, Density, Sonic, Neutron, Other (Describe) _____

Name of Organization Running Log

GEOLOGIC DATA (Office Use Only)

Surface Elev.	Geologic Unit	Unit Thickness	Depth to Top
Subs. SWL	Date	Analysis	Aquifer Test

Driller's Remarks

Well has 15' of 8" Screen on Bottom Pipe. Slot 013

SCREEN DATA

Diameter - Inches	Length - Feet	Slot Size - Inches
4"	30'	.013
Screen Type	**Depth to Bottom - Feet**	
PVC	155'	

DESCRIPTION OF FORMATIONS ENCOUNTERED	FROM	TO
Red Clay	0	15
Red Sand & Gravel	15	35
White Sand	35	140
White Sand	140	155

FORMATIONS (Continued) FROM TO

IF MORE SPACE IS NEEDED, USE BACK

RECEIVED
NOV 09 1987
Department of Natural Resources
Bureau of Land & Water Resources

If well telescopes please
sketch and show depths.

GROUND LEVEL

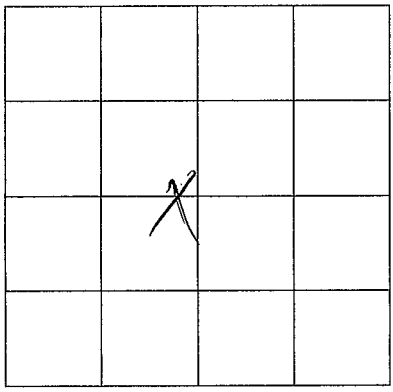

SECTION 17

Please indicate well location X.

ADDITIONAL INFORMATION

If more than one screen,
show location of each on sketch.