MISSISSIPPI DEPARTMENT OF ENVIRONMENTAL QUALITY
Bureau of Land and Water Resources

P. O. Box 10631
Jackson, MS 39289-0631
WATER WELL DRILLERS LOG

COUNTY WELL LOCATED	~~Marshall~~ TATE
WELL NUMBER	~~AT~~ D
CODED	
	2108
DATE WELL COMPLETED	6-27-91

PERMIT NUMBER	
NAME OF DRILLING FIRM	HICKS WELL CO.
	RT. 1 BOX 157
	SENATOBIA, MS 38668

NAME & MAILING ADDRESS OF LANDOWNER
Donald Young
8544 West Carona #42
Olive Branch, MS 386

WELL LOCATION: SEC 28 TOWNSHIP 1 N (S) RANGE 5 E (W)

DISTANCE 3 Miles DIRECTION W of NEAREST TOWN Watson

OTHER LANDMARK

WELL PURPOSE: Home, Irrigation, Municipal, Industrial, Fish Pond, etc.

PUMP DATA

PUMP TYPE (Circle One): Submersible, Turbine, Jet Flowing Well, Other (Describe) _____

POWER TYPE (Circle One): Electric, Tractor, Diesel, Gasoline, Butane, Other (Describe) _____ H/P 1/2

Pump Capacity (GPM)	No. of Stages	Setting Depth
10	9	100 FT.

PUMP TEST

Well yielded _____ GPM with a drawdown of _____ ft. after _____ hours of pumping

WELL DATA

Well Depth	Casing Diameter (In.)	Casing Length (Ft.)
120	4	110

Type of Casing	Hole Depth	Depth to Static Water Level
PVC	120	75

TYPE OF COMPLETION: (Circle One or More): Gravel Packed, Underreamed, Telescoped, Natural Development, Open Hole, Other (Describe) _____

Top of Lap Pipe or Reduction in Casing FEET

IF TELESCOPED OR MORE THAN ONE SCREEN: USE BACK PAGE

SCREEN DATA

Diameter - Inches	Length - Feet	Slot Size - Inches
4	10'	013

Screen Type	Depth to Bottom - Feet
PVC	101

LOG DATA

TYPE OF LOG RUN (Circle One): No Log Run, Electric, Gamma Ray, Density, Sonic, Neutron, Other (Describe) _____

Name of Organization Running Log

GEOLOGIC DATA (Office Use Only)

Surface Elev.	Geologic Unit	Unit Thickness	Depth to Top
Subs. SWL	Date	Analysis	Aquifer Test

Driller's Remarks

DESCRIPTION OF FORMATIONS ENCOUNTERED	FROM	TO
Dirt	0	20
Clay	20	80
W. Sand	80	120

FORMATIONS (Continued)	FROM	TO

RECEIVED
SEP 16 1991
Dept. of Environmental Quality
Bureau of Land & Water Resources

IF MORE SPACE IS NEEDED, USE BACK

If well telescopes please
sketch and show depths.

GROUND LEVEL

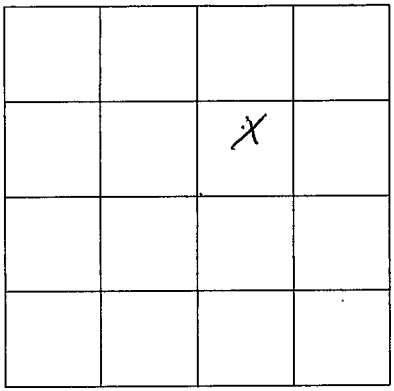

SECTION _____

Please indicate well location X.

ADDITIONAL INFORMATION

If more than one screen,
show location of each on sketch.