MISSISSIPPI DEPARTMENT OF ENVIRONMENTAL QUALITY
Office of Land and Water Resources

P. O. Box 10631
Jackson, MS 39289-0631
WATER WELL DRILLERS LOG

COUNTY WELL LOCATED	Tate
WELL NUMBER	D 2130
CODED	
DATE WELL COMPLETED	6-3-01
PERMIT NUMBER	
NAME OF DRILLING FIRM	N. MS Well DR
	R. Langford

NAME & MAILING ADDRESS OF LANDOWNER: Celeste Vizina, Cedar Chest Cove, Independence MS

WELL LOCATION	SEC	TOWNSHIP	RANGE
	30	4 (N/S)	5 (E/W)

DISTANCE	DIRECTION	NEAREST TOWN
3 Miles	W	of Independence

OTHER LANDMARK:

WELL PURPOSE: (Home) Irrigation, Municipal, Industrial, Fish Pond, etc.

PUMP DATA

PUMP TYPE (Circle One): (Submersible) Turbine, Jet, Flowing Well, Other (Describe)

POWER TYPE (Circle One): (Electric) Tractor, Diesel, Gasoline, 1/2 Butane, Other (Describe) H/P

Pump Capacity (GPM)	No of Stages	Setting Depth
12		130 FT.

PUMP TEST

Well yielded 15 GPM with a drawdown of 5 ft. after 3 hours of pumping

WELL DATA

Well Depth	Casing Diameter (In.)	Casing Length (Ft.)
150	4	20

Type of Casing	Hole Depth	Depth to Static Water Level
PVC	150	50' F. Top

TYPE OF COMPLETION: (Circle One or More): Gravel Packed, Underreamed, Telescoped, (Natural Development), Open Hole, Other (Describe)

WELL GROUTED TO A DEPTH OF _____ FEET
Type Grout (circle one): Cement, Bentonite, or Mix

LOG DATA

TYPE OF LOG RUN (Circle One): (No Log Run), Electric, Gamma Ray, Density, Sonic, Neutron, Other (Describe)

Name of Organization Running Log

GEOLOGIC DATA (Office Use Only)

Surface Elev	Geologic Unit	Unit Thickness	Depth to Top
Subs. SWL	Date	Analysis	Aquifer Test

Driller's Remarks

SCREEN DATA

Diameter - Inches	Length - Feet	Slot Size - Inches
4	10	.010

Screen Type	Depth to Bottom - Feet
PVC. Slotted	150

Top of Lap Pipe or Reduction in Casing: FEET

IF TELESCOPED OR MORE THAN ONE SCREEN: USE BACK PAGE

DESCRIPTION OF FORMATIONS ENCOUNTERED	FROM	TO	FORMATIONS (Continued)	FROM	TO
Dirt	0	20			
Red Sand	20	40			
Sand	40	60			
Some Gravel	60	70			
w/ Clay	70	80			
w/ Sand	80	150			
			IF MORE SPACE IS NEEDED, USE BACK		

RECD JUN 11 2001

If well telescopes please sketch and show depths.

GROUND LEVEL

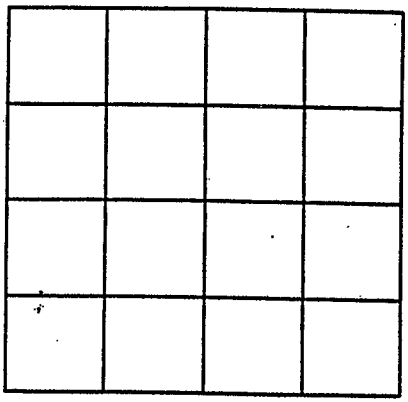

SECTION _____

Please indicate well location X.

ADDITIONAL INFORMATION

If more than one screen,