Tate
E 2012
4-8-76

MISSISSIPPI
BOARD OF WATER COMMISSIONERS
416 North State Street
15E Jackson, Mississippi 39201

WATER WELL DRILLERS LOG

4-8- 1976 Bob Smith Well Sr. Tate
date well completed — firm name — county well located

LANDOWNER: David Hombuckle
Coldwater, Ms
(mailing address)

WELL LOCATION:
sec. 2 T 5 N (S) R 8 E (W)
3 miles W of Coldwater
(distance) (direction) (nearest town)

WELL PURPOSE: Home
(home, irrigation, municipal, industrial)

WELL COMPLETION DATA:

(1) diameter (inches) 4"
(2) total depth (feet) 120
(3) static water level (feet) 35 below above top of ground.
(4) casing Plastic (material), 120 (depth),
_____ (size) If telescope see back.
(5) screen 10 (length), 110 (depth to top)
4" (size), Plastic (material)
(6) pump 1/2 (HP) 10 (yield gpm)
Elec (type power)
(7) electric log no (yes or no)
_____ (organization running log)
(8) how well bottom plugged Plugged

DRILLERS REMARKS:

description of formations encountered	from	to
top soil	0	10
red soil	10	80
fine white sand	80	100
coarse sand	100	120

RECEIVED MAY 27 1976 MISS. BD. OF WATER COMMISS.

If well telescopes please sketch and show depths.

GROUND LEVEL

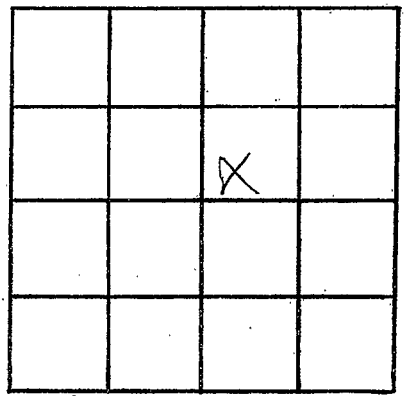

SECTION _____

Please indicate well location X.

ADDITIONAL INFORMATION

If more than one screen, show locations of each on sketch.