Tate
F 2015
9-11-76

15E

MISSISSIPPI
BOARD OF WATER COMMISSIONERS
416 North State Street
Jackson, Mississippi 39201

WATER WELL DRILLERS LOG

9-11 1976 Hinds Well Co. Tate
date well completed — firm name — county well located

LANDOWNER: George Eddings
Rt. 2
Coldwater, Miss
(mailing address)

WELL LOCATION:
sec. 2 T 5 N (S) R 8 E (W)
2 miles SW of Coldwater
(distance) (direction) (nearest town)

WELL PURPOSE: Home
(home, irrigation, municipal, industrial)

WELL COMPLETION DATA:
(1) diameter (inches) 4
(2) total depth (feet) 155
(3) static water level (feet) Cd below above top of ground.
(4) casing PVC (material), 155 (depth),
(size) If telescope see back.
(5) screen 4 (length), 151 (depth to top)
4" (size), gravel (material)
(6) pump 1/2 (HP) 10 (yield gpm)
220V (type power)
(7) electric log NO (yes or no)
(organization running log)
(8) how well bottom plugged Cap

DRILLERS REMARKS:

description of formations encountered	from	to
Red Clay	0	15
Gravel	15	25
Red Clay	25	95
Red Sand + Clay	95	125
White Sand	125	155

RECEIVED
OCT - 5 1976
MISS. BD. OF WATER COMM.

If well telescopes please sketch and show depths.

GROUND LEVEL

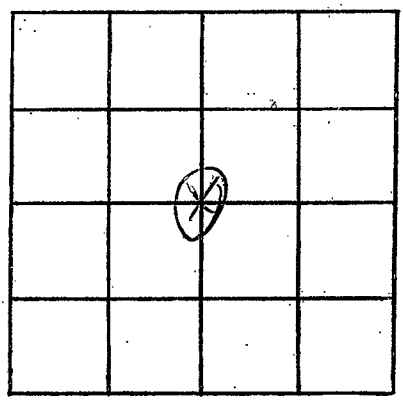

SECTION 2

Please indicate well location X.

ADDITIONAL INFORMATION

If more than one screen, show locations of each on sketch.