TATE
G40
2-23-72

MISSISSIPPI
BOARD OF WATER COMMISSIONERS
416 North State Street
Jackson, Mississippi 39201

WATER WELL DRILLERS LOG

Sub mtn June 12-72
CODED
Rec 3/2/72 for ex

2-23- 1972 Cannon & Thorpe Well Sup Tate
date well completed firm name county well located

LANDOWNER: Tom Wilson
Senatobia, Miss.
(mailing address)

WELL LOCATION:
sec 25 T 5 N/S R 7 E/W
6 (distance) miles West (direction) of Senatobia (nearest town)

WELL PURPOSE: home
(home, irrigation, municipal, industrial)

WELL COMPLETION DATA:

(1) diameter (inches) 4"
(2) total depth (feet) 84'
(3) static water level (feet) 30 below ~~above~~ top of ground.
(4) casing P.V.C. (material), 84' (depth),
_____ (size) if telescope see back.
(5) screen 5' (length), 79' (depth to top)
4" (size), filter Pack (material)
(6) pump 3/4 (HP) 10 (yield gpm)
220 (type power)
(7) electric log _____ (yes or no)
_____ (organization running log)
(8) how well bottom plugged 4" P.V.C. Cap.

DRILLERS REMARKS:

description of formations encountered	from	to
Top Soil	0	10
red clay	10	35
gravel	35	40
white coarse sand	40	84

CODED

MAR 27 1972

If well telescopes please sketch and show depths.

GROUND LEVEL

If more than one screen, show locations of each on sketch.

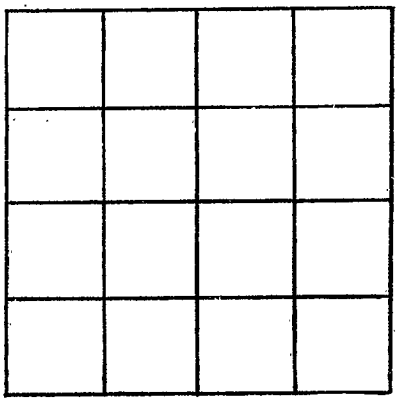

SECTION _____

Please indicate well location X.

ADDITIONAL INFORMATION