Zato
G 2031
7-13-77

15E

MISSISSIPPI
BOARD OF WATER COMMISSIONERS
416 North State Street
Jackson, Mississippi 39201

WATER WELL DRILLERS LOG

7-13 1977 Harris Bros. Zato
date well completed — firm name — county well located

LANDOWNER: W.R. Dougherty
P.O. Box 586
Senatobia
(mailing address)

WELL LOCATION:
sec. 5 T 5 N (S) R 7 E (W)
1 miles E of Coldwater
(distance) (direction) (nearest town)

WELL PURPOSE: home
(home, irrigation, municipal, industrial)

WELL COMPLETION DATA:
(1) diameter (inches) 4
(2) total depth (feet) 130
(3) static water level (feet) 80 below above top of ground.
(4) casing Plastic (material), 123 (depth),
4 (size) if telescope see back.
(5) screen 7 (length), 123 (depth to top)
POR (size), Plastic (material)
(6) pump 3/4 (HP) 7 (yield gpm)
elec (type power)
(7) electric log no (yes or no)
(organization running log)
(8) how well bottom plugged solid

DRILLERS REMARKS:

description of formations encountered	from	to
top soil	0	20
red sand	20	45
white Clay + sand	45	110
Coarse sand	110	130

RECEIVED
SEP 30 1977
MISS. BD. OF WATER COMM.

If well telescopes please sketch and show depths.

GROUND LEVEL

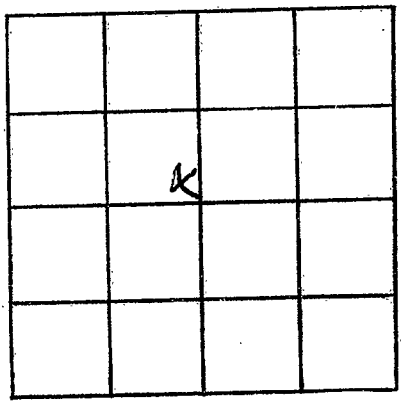

SECTION 5

Please indicate well location X.

ADDITIONAL INFORMATION

If more than one screen, show locations of each on sketch.