MISSISSIPPI DEPARTMENT OF NATURAL RESOURCES

Bureau of Land and Water Resources

P.O. Box 10631
Jackson, Mississippi 39209

WATER WELL DRILLERS LOG

COUNTY WELL LOCATED	TATE
WELL NUMBER	G
CODED	
	2081
DATE WELL COMPLETED	7-14-86
PERMIT NUMBER	
NAME OF DRILLING FIRM	Hicks Well Co
	Senatobia, MS.

NAME & MAILING ADDRESS OF LANDOWNER

S. E. McRAe

RT. 2

Coldwater, MS

WELL LOCATION: SEC 27 TOWNSHIP 5 N/S RANGE 7 E/W

DISTANCE 3 Miles DIRECTION N/E of NEAREST TOWN Coldwater

OTHER LANDMARK

Ben Winn Curve

WELL PURPOSE: Home, Irrigation, Municipal, Industrial, Fish Pond, etc.

PUMP DATA

PUMP TYPE (Circle One): Submersible, Turbine, Jet Flowing Well, Other (Describe) _____

POWER TYPE (Circle One): Electric, Tractor, Diesel, Gasoline, Butane, Other (Describe) _____

Pump Capacity (GPM)	No. of Stages	Setting Depth
10	7	80 FT.

PUMP TEST

Well yielded 10 GPM with a drawdown of — ft. after — hours of pumping

WELL DATA

Well Depth	Casing Diameter (In.)	Casing Length (Ft.)
125	4"	115

Type of Casing	Hole Depth	Depth to Static Water Level
PVC	125	40

TYPE OF COMPLETION: (Circle One or More): Gravel Packed, Underreamed, Telescoped, Natural Development, Open Hole, Other (Describe) _____

Top of Lap Pipe or Reduction in Casing

FEET

IF TELESCOPED OR MORE THAN ONE SCREEN: USE BACK PAGE

LOG DATA

TYPE OF LOG RUN (Circle One): No Log Run, Electric, Gamma Ray, Density, Sonic, Neutron, Other (Describe) _____

Name of Organization Running Log

GEOLOGIC DATA (Office Use Only)

Surface Elev.	Geologic Unit	Unit Thickness	Depth to Top
Subs. SWL	Date	Analysis	Aquifer Test

Driller's Remarks

SCREEN DATA

Diameter - Inches	Length - Feet	Slot Size - Inches
4"	10'	013

Screen Type	Depth to Bottom - Feet
Slotted - PVC	10

DESCRIPTION OF FORMATIONS ENCOUNTERED	FROM	TO
R.C.	0	25
R S	25	50
W S & C	50	80
W S.	80	140

FORMATIONS (Continued)	FROM	TO

RECEIVED
SEP 05 1986
Department of Natural Resources
Bureau of Land & Water Resources

IF MORE SPACE IS NEEDED, USE BACK

If well telescopes please
sketch and show depths.

GROUND LEVEL

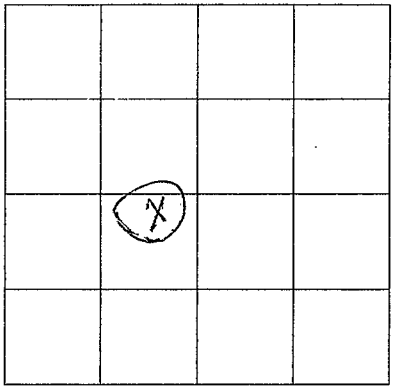

SECTION _____

Please indicate well location X.

ADDITIONAL INFORMATION

If more than one screen,
show location of each on sketch.