MISSISSIPPI DEPARTMENT OF NATURAL RESOURCES

Bureau of Land and Water Resources

P.O. Box 10631
Jackson, Mississippi 39209
WATER WELL DRILLERS LOG

COUNTY WELL LOCATED: TATE	
WELL NUMBER: G	CODED:
DATE WELL COMPLETED: 2-87	
PERMIT NUMBER:	
NAME OF DRILLING FIRM: HICKS WELL COMPANY, RT. 1 BOX 157, SENATOBIA, MISS.	

NAME & MAILING ADDRESS OF LANDOWNER
TATE CO. COOP
Senatobia, MS.
38668

WELL LOCATION: SEC 6 TOWNSHIP 5 N (S) RANGE 7 E (W)

DISTANCE 1 Miles DIRECTION SOUTH of NEAREST TOWN Coldwater

OTHER LANDMARK

WELL PURPOSE: Home, Irrigation, Municipal, (Industrial), Fish Pond, etc.
For shop & Fert. Plant

PUMP DATA

PUMP TYPE (Circle One): (Submersible), Turbine, Jet, Flowing Well, Other (Describe)

POWER TYPE (Circle One): (Electric), Tractor, Diesel, Gasoline, Butane, Other (Describe) H/P 1

Pump Capacity (GPM)	No. of Stages	Setting Depth
18	18	90 FT.

PUMP TEST

Well yielded 18 GPM with a drawdown of ft. after hours of pumping

WELL DATA

Well Depth	Casing Diameter (In.)	Casing Length (Ft.)
100	4"	90

Type of Casing	Hole Depth	Depth to Static Water Level
PVC	100	60

TYPE OF COMPLETION: (Circle One or More): (Gravel Packed), Underreamed, Telescoped, Natural Development, Open Hole, Other (Describe)

Top of Lap Pipe or Reduction in Casing FEET

IF TELESCOPED OR MORE THAN ONE SCREEN: USE BACK PAGE

LOG DATA

TYPE OF LOG RUN (Circle One): No Log Run, Electric, Gamma Ray, Density, Sonic, Neutron, Other (Describe)

Name of Organization Running Log

GEOLOGIC DATA (Office Use Only)

Surface Elev.	Geologic Unit	Unit Thickness	Depth to Top
Subs. SWL	Date	Analysis	Aquifer Test

Driller's Remarks

SCREEN DATA

Diameter - Inches	Length - Feet	Slot Size - Inches
4"	10	013

Screen Type	Depth to Bottom - Feet
PVC	10

DESCRIPTION OF FORMATIONS ENCOUNTERED	FROM	TO	FORMATIONS (Continued)	FROM	TO
R.C.	0	20			
WS — C	20	60			
WS	60	100			

RECEIVED
NOV 06 1989
Department of Natural Resources
Bureau of Land & Water Resources

IF MORE SPACE IS NEEDED, USE BACK

If well telescopes please
sketch and show depths.

GROUND LEVEL

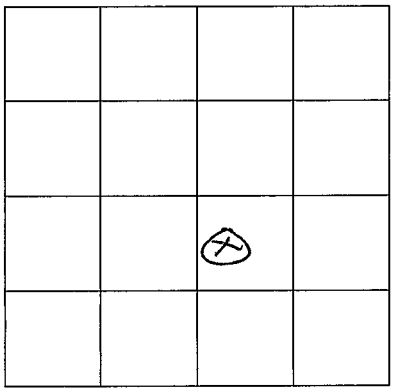

SECTION 6

Please indicate well location X.

ADDITIONAL INFORMATION

If more than one screen,
show location of each on sketch.