Tate
H 2025
12/1/76

15E

MISSISSIPPI
BOARD OF WATER COMMISSIONERS
416 North State Street
Jackson, Mississippi 39201

WATER WELL DRILLERS LOG

12-1 19 76 Hicks Well Co. Tate
date well completed — firm name — county well located

LANDOWNER: Sam Davis
Rt. 2, Box 315
Coldwater Miss.
(mailing address)

WELL LOCATION:
sec. 21 T. 5 N (S) R 6 E (W)
4 miles SE of Independence
(distance) (direction) (nearest town)

WELL PURPOSE: Home
(home, irrigation, municipal, industrial)

WELL COMPLETION DATA:

(1) diameter (inches) 4
(2) total depth (feet) 90
(3) static water level (feet) 65 below above top of ground.
(4) casing PVC (material), 90 (depth),
(size) if telescope see back.
(5) screen 4' (length), 86' (depth to top)
4" (size), Screw Type (material)
(6) pump 1/2 (HP) 10 (yield gpm)
220 V (type power)
(7) electric log No (yes or no)
(organization running log)
(8) how well bottom plugged Cap

DRILLERS REMARKS:

description of formations encountered	from	to
Red Clay	0	20
Red Clay + Sand	20	40
Red Sand	40	60
White Sand	60	90

RECEIVED
JAN 4 1977
MISS. BD. OF WATER COMM.

If well telescopes please sketch and show depths.

GROUND LEVEL

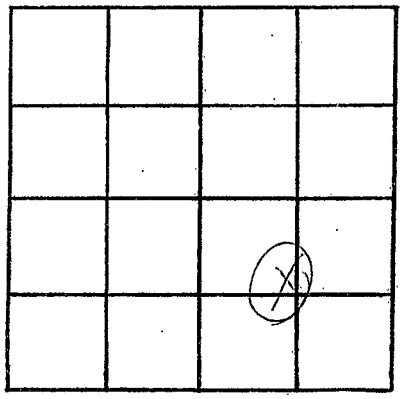

SECTION 1

Please indicate well location X.

ADDITIONAL INFORMATION

If more than one screen, show locations of each on sketch.