Tate
H 2049
June 11, 1979

MISSISSIPPI
BOARD OF WATER COMMISSIONERS
416 North State Street
Jackson, Mississippi 39201

WATER WELL DRILLERS LOG

6-11-79 (date well completed) 19 79 — Hicks Well Co. (firm name) — Tate (county well located)

LANDOWNER: Bobby Payne
Rt. 2, Coldwater Miss
(mailing address)

WELL LOCATION:
sec. 14 T 5 N (S) R 6 E (W)
3 (distance) miles S (direction) of Independence (nearest town)

WELL PURPOSE: home
(home, irrigation, municipal, industrial)

WELL COMPLETION DATA:

(1) diameter (inches) 4 in
(2) total depth (feet) 130
(3) static water level (feet) _____ below / above top of ground
(4) casing Plastic (material), 130 (depth),
_____ (size) if telescope see back.
(5) screen 7 ft (length), 123 (depth to top)
4 in (size), Gravel (material)
(6) pump 1/2 (HP) 10 (yield gpm)
220 (type power)
(7) electric log No (yes or no)
_____ (organization running log)
(8) how well bottom plugged Cap

DRILLERS REMARKS:

description of formations encountered	from	to
Red Clay	0	20
Red Sand	20	70
White Sand	70	130

Miss. Board of Water Comm.
JUL 2 1979
RECEIVED

If well telescopes please sketch and show depths.

GROUND LEVEL

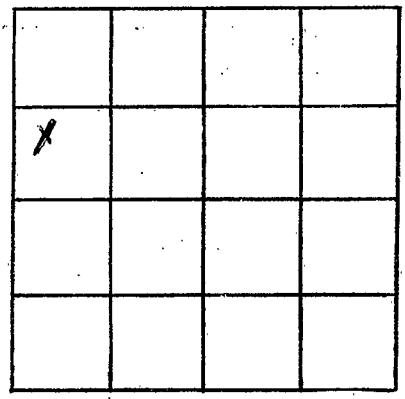

SECTION 14

Please indicate well location X.

ADDITIONAL INFORMATION

If more than one screen, show locations of each on sketch.