MISSISSIPPI DEPARTMENT OF NATURAL RESOURCES

Bureau of Land and Water Resources

P.O. Box 10631
Jackson, Mississippi 39209

WATER WELL DRILLERS LOG

COUNTY WELL LOCATED: Tate	
WELL NUMBER: 4	CODED:
2110	
DATE WELL COMPLETED: 7-1-88	

PERMIT NUMBER
NAME OF DRILLING FIRM: HICKS WELL COMPANY
RT. 1 - BOX 157

NAME & MAILING ADDRESS OF LANDOWNER: SENATOBIA, MISS.

Arthur Forman
Rt. 3 Silver Hills
Senatobia, Ms. 38668

WELL LOCATION: SEC 32 TOWNSHIP 5 N (S) RANGE 6 E (W)

DISTANCE _____ Miles DIRECTION _____ of NEAREST TOWN _____

OTHER LANDMARK

WELL PURPOSE: Home, Irrigation, Municipal, Industrial, Fish Pond, etc.

PUMP DATA

PUMP TYPE (Circle One): Submersible, Turbine, Jet, Flowing Well, Other (Describe) _____

POWER TYPE (Circle One): Electric, Tractor, Diesel, Gasoline, Butane, Other (Describe) _____

Pump Capacity (GPM)	No. of Stages	Setting Depth
25	20	120 FT.

PUMP TEST

Well yielded _____ GPM with a drawdown of _____ ft. after _____ hours of pumping

WELL DATA

Well Depth	Casing Diameter (In.)	Casing Length (Ft.)
160	4	140
Type of Casing	**Hole Depth**	**Depth to Static Water Level**
PVC	160	80

TYPE OF COMPLETION: (Circle One or More): Gravel Packed, Underreamed, Telescoped, Natural Development, Open Hole, Other (Describe) _____

Top of Lap Pipe or Reduction in Casing _____ FEET

IF TELESCOPED OR MORE THAN ONE SCREEN: USE BACK PAGE

LOG DATA

TYPE OF LOG RUN (Circle One): Electric, Gamma Ray, Density, Sonic, Neutron, Other (Describe) _____ No Log Run

Name of Organization Running Log

GEOLOGIC DATA (Office Use Only)

Surface Elev.	Geologic Unit	Unit Thickness	Depth to Top
Subs. SWL	Date	Analysis	Aquifer Test

Driller's Remarks

RECEIVED
SEP 21 1988
Department of Natural Resources
Bureau of Land & Water Resources

SCREEN DATA

Diameter - Inches	Length - Feet	Slot Size - Inches
4	20	.013
Screen Type		**Depth to Bottom - Feet**
PVC		0

DESCRIPTION OF FORMATIONS ENCOUNTERED	FROM	TO
Red Clay	0	10
Gravel	10	25
White Sand	25	160

FORMATIONS (Continued)	FROM	TO

IF MORE SPACE IS NEEDED, USE BACK

If well telescopes please
sketch and show depths.

GROUND LEVEL

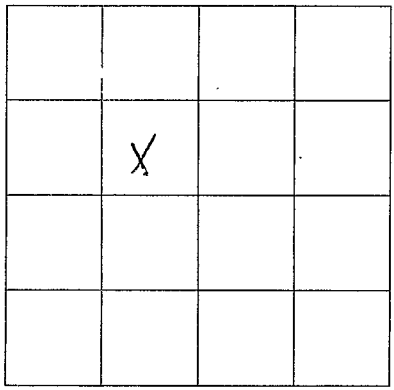

SECTION 32

Please indicate well location X.

ADDITIONAL INFORMATION

If more than one screen,
show location of each on sketch.