MISSISSIPPI DEPARTMENT OF NATURAL RESOURCES

Bureau of Land and Water Resources

P.O. Box 10631
Jackson, Mississippi 39209

WATER WELL DRILLERS LOG

COUNTY WELL LOCATED	TATE
WELL NUMBER	H
CODED	
	2120
DATE WELL COMPLETED	12-19-90

PERMIT NUMBER

NAME OF DRILLING FIRM: HICKS WELL CO.
RT. 1 BOX 157
SENATOBIA, MS 38668

NAME & MAILING ADDRESS OF LANDOWNER

Dillie SMART
RT-1
Senatobia, MS

WELL LOCATION: SEC 35 TOWNSHIP 5 N (S) RANGE 4 E (W)

DISTANCE 3 Miles DIRECTION E NEAREST TOWN of Looxahoma

OTHER LANDMARK

WELL PURPOSE: (Home), Irrigation, Municipal, Industrial, Fish Pond, etc.

PUMP DATA

PUMP TYPE (Circle One): (Submersible), Turbine, Jet, Flowing Well, Other (Describe) _____

POWER TYPE (Circle One): (Electric), Tractor, Diesel, Gasoline, Butane, Other (Describe) _____ H/P _____

Pump Capacity (GPM)	No. of Stages	Setting Depth
10	9	70 FT.

PUMP TEST

Well yielded 10 GPM with a drawdown of _____ ft. after _____ hours of pumping

WELL DATA

Well Depth	Casing Diameter (In.)	Casing Length (Ft.)
110	4"	100

Type of Casing	Hole Depth	Depth to Static Water Level
PVC	110	60

TYPE OF COMPLETION: (Circle One or More): (Gravel Packed), Underreamed, Telescoped, Natural Development, Open Hole, Other (Describe) _____

Top of Lap Pipe or Reduction in Casing FEET

IF TELESCOPED OR MORE THAN ONE SCREEN: USE BACK PAGE

LOG DATA

TYPE OF LOG RUN (Circle One): No Log Run, Electric, Gamma Ray, Density, Sonic, Neutron, Other (Describe) _____

Name of Organization Running Log

GEOLOGIC DATA (Office Use Only)

Surface Elev.	Geologic Unit	Unit Thickness	Depth to Top
Subs. SWL	Date	Analysis	Aquifer Test

Driller's Remarks

SCREEN DATA

Diameter - Inches	Length - Feet	Slot Size - Inches
4"	10'	013

Screen Type	Depth to Bottom - Feet
PVC	10'

DESCRIPTION OF FORMATIONS ENCOUNTERED	FROM	TO
clay	0	20
wc & s	20	60
s	60	110

FORMATIONS (Continued)	FROM	TO

RECEIVED
JAN 30 1991
Dept. of Environmental Quality
Bureau of Land & Water Resources

IF MORE SPACE IS NEEDED, USE BACK

If well telescopes please
sketch and show depths.

GROUND LEVEL

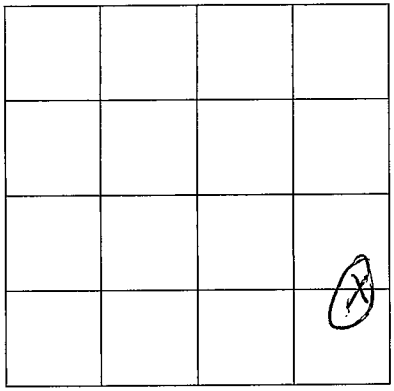

SECTION _____

Please indicate well location X.

ADDITIONAL INFORMATION

If more than one screen,
show location of each on sketch.