MISSISSIPPI DEPARTMENT OF ENVIRONMENTAL QUALITY
Office of Land and Water Resources

P. O. Box 10631
Jackson, MS 39289-0631

WATER WELL DRILLERS LOG

COUNTY WELL LOCATED: THT	
WELL NUMBER: H2190	CODED:
DATE WELL COMPLETED: 5-16-00	
PERMIT NUMBER:	
NAME OF DRILLING FIRM: N. MS Well Dr / F Langford	

NAME & MAILING ADDRESS OF LANDOWNER: Tim Roberson, Barr Rd, Senatobia MS

WELL LOCATION: SEC 13 TOWNSHIP 5 N (S) RANGE 6 E (W)

DISTANCE: 10 Miles DIRECTION: W of NEAREST TOWN: Senatobia

OTHER LANDMARK:

WELL PURPOSE: Home, Irrigation, Municipal, Industrial, Fish Pond, etc.

PUMP DATA

PUMP TYPE (Circle One): Submersible, Turbine, Jet, Flowing Well, Other (Describe)

POWER TYPE (Circle One): Electric, Tractor, Diesel, Gasoline, 1/2 Butane, Other (Describe) H/P

Pump Capacity (GPM)	No of Stages	Setting Depth
12		120 FT.

PUMP TEST

Well yielded 15 GPM with a drawdown of 3 ft. after 1 hours of pumping

WELL DATA

Well Depth	Casing Diameter (In.)	Casing Length (Ft.)
180	4	20

Type of Casing	Hole Depth	Depth to Static Water Level
PVC	180	65 ft Top

TYPE OF COMPLETION: (Circle One or More): Gravel Packed, Underreamed, Telescoped, Natural Development, Open Hole, Other (Describe)

WELL GROUTED TO A DEPTH OF _____ FEET
Type Grout (circle one): Cement, Bentonite, or Mix

LOG DATA

TYPE OF LOG RUN (Circle One): No Log Run, Electric, Gamma Ray, Density, Sonic, Neutron, Other (Describe)

Name of Organization Running Log

GEOLOGIC DATA (Office Use Only)

Surface Elev	Geologic Unit	Unit Thickness	Depth to Top
Subs. SWL	Date	Analysis	Aquifer Test

Driller's Remarks

SCREEN DATA

Diameter - Inches	Length - Feet	Slot Size - Inches
4	10	.013

Screen Type	Depth to Bottom - Feet
PVC	180

Top of Lap Pipe or Reduction in Casing FEET

IF TELESCOPED OR MORE THAN ONE SCREEN: USE BACK PAGE

DESCRIPTION OF FORMATIONS ENCOUNTERED	FROM	TO	FORMATIONS (Continued)	FROM	TO
Dirt	0	15			
Red Sand	15	30			
Sand	30	80			
W/Clay	80	100			
W/ Sand	100	180			
			IF MORE SPACE IS NEEDED, USE BACK		

REC'D JUN 11 2001

If well telescopes please sketch and show depths.

GROUND LEVEL

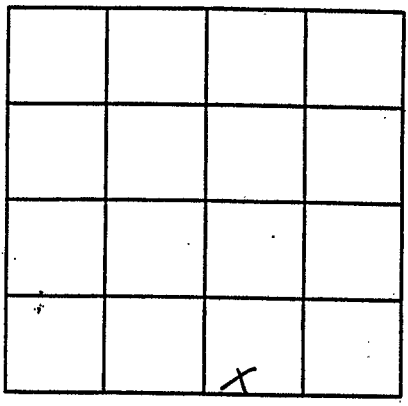

SECTION 13

Please indicate well location X.

ADDITIONAL INFORMATION

If more than one screen,