Tate
J46
6-3-75

CODED

MISSISSIPPI
BOARD OF WATER COMMISSIONERS
416 North State Street
Jackson, Mississippi 39201

WATER WELL DRILLERS LOG

6-3 1975 Johnson Well Co. Tate
date well completed — firm name — county well located

LANDOWNER: Eddie Geelin
Route 2, Coldwater, Miss
(mailing address)

WELL LOCATION:
sec. 6 T 5 N (S) R 5 E (W) 15E
2 miles SW of Bet
(distance) (direction) (nearest town)

WELL PURPOSE: Home
(home, irrigation, municipal, industrial)

WELL COMPLETION DATA:

(1) diameter (inches) 4 in
(2) total depth (feet) 130
(3) static water level (feet) 60 below above top of ground.
(4) casing Plastic, ____ (material) (depth),
____ (size) if telescope see back.
(5) screen 4 ft, 126 (length) (depth to top)
4 in, Gravel (size) (material)
(6) pump 1/2 (HP) 10 (yield gpm)
Electric 220 (type power)
(7) electric log no (yes or no)
____ (organization running log)
(8) how well bottom plugged Cap

DRILLERS REMARKS:

description of formations encountered	from	to
Red Sand & Gravel	0	15
Red Sand	15	30
Red Sand & Clay	30	45
Red Sand	45	60
White Sand	60	130

CODED

RECEIVED
JUL 21 1975
MISS. BD. OF WATER COMM.

If well telescopes please sketch and show depths.

GROUND LEVEL

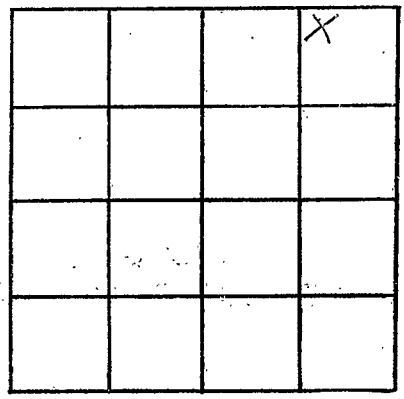

SECTION 6

Please indicate well location X.

ADDITIONAL INFORMATION

If more than one screen, show locations of each on sketch.