Date
J 2017
7-21-81

MISSISSIPPI DEPARTMENT OF NATURAL RESOURCES

Bureau of Land and Water Resources
Southport Mall
P.O. Box 10631
Jackson, Mississippi 39209

WATER WELL DRILLERS LOG

7-21 1981 Hicks Well Co. Tate
date well completed — firm name — county well located

LANDOWNER: William C. Freeman
Rt. 5
Holly Springs, Ms.
(mailing address)

WELL LOCATION:
sec. 25 T 5 N (S) R 5 E (W)
1 (distance) miles S (direction) of Wyatte (nearest town)

WELL PURPOSE: Home
(home, irrigation, municipal, industrial)

WELL COMPLETION DATA:
(1) diameter (inches) 4
(2) total depth (feet) 220
(3) static water level (feet) 180 below above top of ground.
(4) casing PVC (material), 220 (depth),
(size) if telescope see back.
(5) screen 12 (length), 208 (depth to top)
4" (size), gravel & PVC (material)
(6) pump 3/4 (HP) 10 (yield gpm)
220V (type power)
(7) electric log No (yes or no)
(organization running log)
(8) how well bottom plugged Cap

DRILLERS REMARKS:

description of formations encountered	from	to
Red Clay	0	15
White Clay & Sand	15	50
White Sand	50	220

AUG 1981 RECEIVED

If well telescopes please sketch and show depths.

GROUND LEVEL

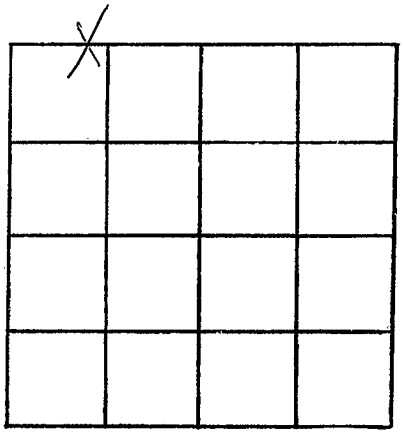

SECTION 25

Please indicate well location X.

ADDITIONAL INFORMATION

If more than one screen, show locations of each on sketch.