Tate
K 3
2-1-68

MISSISSIPPI
BOARD OF WATER COMMISSIONERS
416 North State Street
Jackson, Mississippi 39201

CODED

WATER WELL DRILLERS LOG

2-1 1968 Harris Bros. Tate
date well completed — firm name — county well located

LANDOWNER: Allen Holliday Rte 1 Sarah
(mailing address)

WELL LOCATION:
sec. 17 T 6 N (S) R 9 E (W)
7 miles Southeast of Strayhorn
(distance) (direction) (nearest town)

WELL PURPOSE: home
(home, irrigation, municipal, industrial)

WELL COMPLETION DATA:
(1) diameter (inches) 4"
(2) total depth (feet) 290
(3) static water level (feet) 120 (below) above top of ground.
(4) casing Plastic (material), 276 (depth), 4" (size) if telescope see back.
(5) screen 14' (length), 276 (depth to top), .008 (size), Plastic (material)
(6) pump 3/4 (HP) 10 (yield gpm)
elec. (type power)
(7) electric log No (yes or no)
(organization running log)
(8) how well bottom plugged truck shot

DRILLERS REMARKS:

description of formations encountered	from	to
top soil	0	20
white clay	20	35
gray clay	35	80
sand + clay	80	140
clay	140	200
fine sand	200	265
Coarse sand	265	290

CODED

DEC 23 1968
MISS. BD. OF WATER COMM.

If well telescopes please sketch and show depths.

GROUND LEVEL

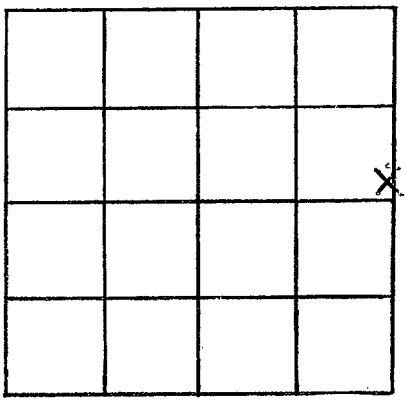

SECTION _____

Please indicate well location X.

ADDITIONAL INFORMATION

If more than one screen, show locations of each on sketch.