MISSISSIPPI DEPARTMENT OF NATURAL RESOURCES

Bureau of Land and Water Resources

P.O. Box 10631
Jackson, Mississippi 39209

WATER WELL DRILLERS LOG

COUNTY WELL LOCATED: Tate	
WELL NUMBER: K	CODED:
2012	
DATE WELL COMPLETED: 4-25-90	

PERMIT NUMBER
NAME OF DRILLING FIRM: Hicks Well Co.

NAME & MAILING ADDRESS OF LANDOWNER: David Yount

Senatobia, MS 38668

WELL LOCATION: SEC 24 TOWNSHIP 6 N (S) RANGE 9 E (W)

DISTANCE 2 Miles DIRECTION NW of NEAREST TOWN Senatobia

OTHER LANDMARK

WELL PURPOSE: (Home) Irrigation, Municipal, Industrial, Fish Pond, etc.

PUMP DATA

PUMP TYPE (Circle One): (Submersible) Turbine, Jet Flowing Well, Other (Describe) ____

POWER TYPE (Circle One): (Electric) Tractor, Diesel, Gasoline, Butane, Other (Describe) ____ H/P ____

Pump Capacity (GPM)	No. of Stages	Setting Depth
10	9	110 FT.

PUMP TEST

Well yielded ____ GPM with a drawdown of ____ ft. after ____ hours of pumping

WELL DATA

Well Depth	Casing Diameter (In.)	Casing Length (Ft.)
130	4"	120

Type of Casing	Hole Depth	Depth to Static Water Level
PVC	130	80

TYPE OF COMPLETION: (Circle One or More): (Gravel Packed) Underreamed, Telescoped, Natural Development, Open Hole, Other (Describe) ____

Top of Lap Pipe or Reduction in Casing FEET

IF TELESCOPED OR MORE THAN ONE SCREEN: USE BACK PAGE

LOG DATA

TYPE OF LOG RUN (Circle One): No Log Run, Electric, Gamma Ray, Density, Sonic, Neutron, Other (Describe) ____

Name of Organization Running Log

GEOLOGIC DATA (Office Use Only)

Surface Elev.	Geologic Unit	Unit Thickness	Depth to Top
Subs. SWL	Date	Analysis	Aquifer Test

Driller's Remarks

SCREEN DATA

Diameter - Inches	Length - Feet	Slot Size - Inches
4"	10'	013

Screen Type	Depth to Bottom - Feet
PVC	10'

DESCRIPTION OF FORMATIONS ENCOUNTERED	FROM	TO
RS & S	0	20
RS & Cr	20	60
RS & C	60	100
WS	100	130

FORMATIONS (Continued)	FROM	TO

RECEIVED
MAY 7 1990
Department of Natural Resources
Bureau of Land & Water Resources

IF MORE SPACE IS NEEDED, USE BACK

If well telescopes please
sketch and show depths.

GROUND LEVEL

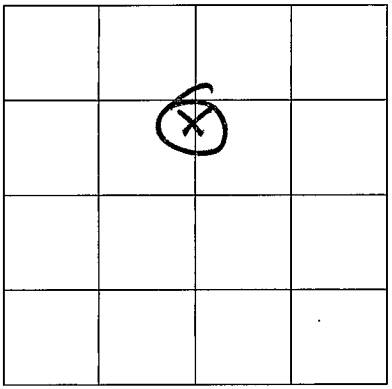

SECTION _____

Please indicate well location X.

ADDITIONAL INFORMATION

If more than one screen,
show location of each on sketch.