MISSISSIPPI DEPARTMENT OF NATURAL RESOURCES

Bureau of Land and Water Resources

P.O. Box 10631
Jackson, Mississippi 39209
WATER WELL DRILLERS LOG

COUNTY WELL LOCATED: Tate	
WELL NUMBER: L	CODED:
2024	
DATE WELL COMPLETED: 5-15-89	
PERMIT NUMBER	
NAME OF DRILLING FIRM: Hicks Well Co	

NAME & MAILING ADDRESS OF LANDOWNER
Addel Hibbler
Rt 2
Senatobia Ms 38668

WELL LOCATION: SEC 1 TOWNSHIP 6 N (S) RANGE 8 E (W)

DISTANCE 2 Miles DIRECTION S of NEAREST TOWN Senatobia

OTHER LANDMARK

WELL PURPOSE: Home, Irrigation, Municipal, Industrial, Fish Pond, etc.

PUMP DATA

PUMP TYPE (Circle One): Submersible, Turbine, Jet, Flowing Well, Other (Describe)

POWER TYPE (Circle One): Electric, Tractor, Diesel, Gasoline, Butane, Other (Describe) H/P 1/2

Pump Capacity (GPM)	No. of Stages	Setting Depth
10 gpm	10	110 FT.

PUMP TEST

Well yielded _____ GPM with a drawdown of _____ ft. after _____ hours of pumping

WELL DATA

Well Depth	Casing Diameter (In.)	Casing Length (Ft.)
160	4"	150

Type of Casing	Hole Depth	Depth to Static Water Level
PVC	160	80

TYPE OF COMPLETION: (Circle One or More): Gravel Packed, Underreamed, Telescoped, Natural Development, Open Hole, Other (Describe)

Top of Lap Pipe or Reduction in Casing FEET

IF TELESCOPED OR MORE THAN ONE SCREEN: USE BACK PAGE

SCREEN DATA

Diameter - Inches	Length - Feet	Slot Size - Inches
4"	10	013

Screen Type	Depth to Bottom - Feet
PVC	160

LOG DATA

TYPE OF LOG RUN (Circle One): No Log Run, Electric, Gamma Ray, Density, Sonic, Neutron, Other (Describe)

Name of Organization Running Log

GEOLOGIC DATA (Office Use Only)

Surface Elev.	Geologic Unit	Unit Thickness	Depth to Top
Subs. SWL	Date	Analysis	Aquifer Test

Driller's Remarks

DESCRIPTION OF FORMATIONS ENCOUNTERED	FROM	TO
R. Clay	0	15
gravel	15	65
white sand	65	160

FORMATIONS Continued | FROM | TO

IF MORE SPACE IS NEEDED, USE BACK

RECEIVED
JUN 8 1989
Department of Natural Resources
Bureau of Land & Water Resources

If well telescopes please
sketch and show depths.

GROUND LEVEL

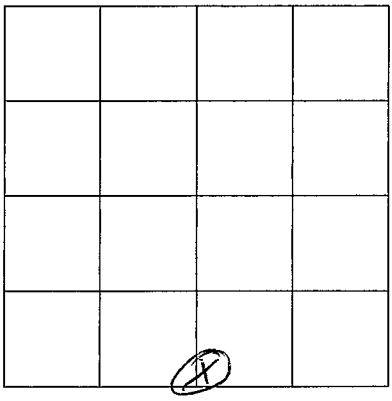

SECTION _____

Please indicate well location X.

ADDITIONAL INFORMATION

If more than one screen,
show location of each on sketch.